


T.11S., R.4W., W.M.

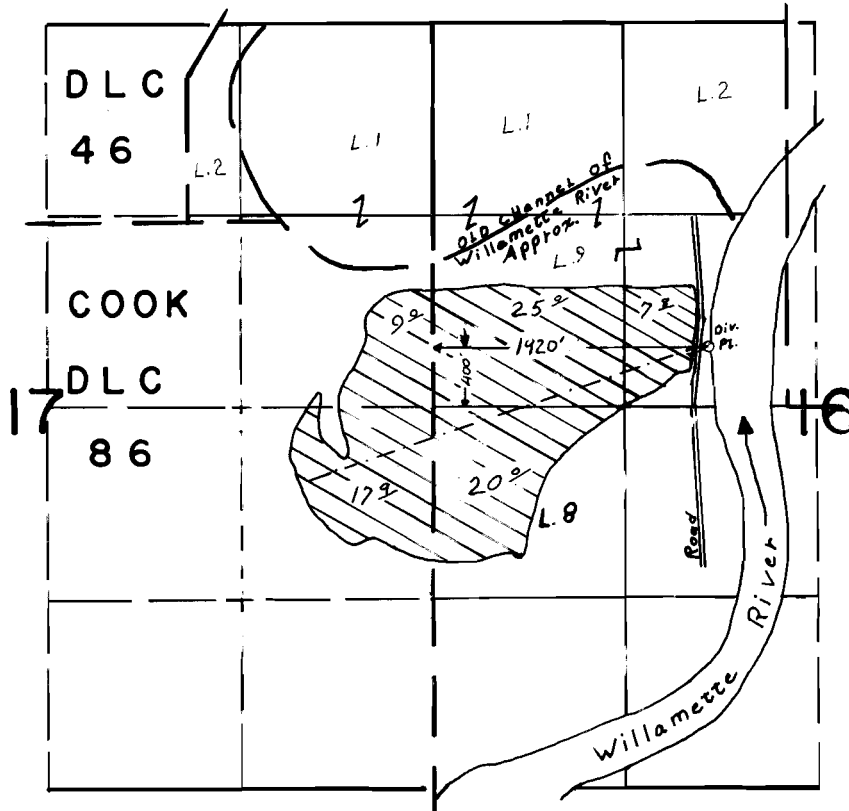

FINAL PROOF SURVEY UNDER

Application No. 49946 Permit No. 37883
IN NAME OF

EDWARD J. REYNOLDS

Surveyed Mar. 31, 1976, by C. R. King