


T.12S.,R.5W.,W.M.

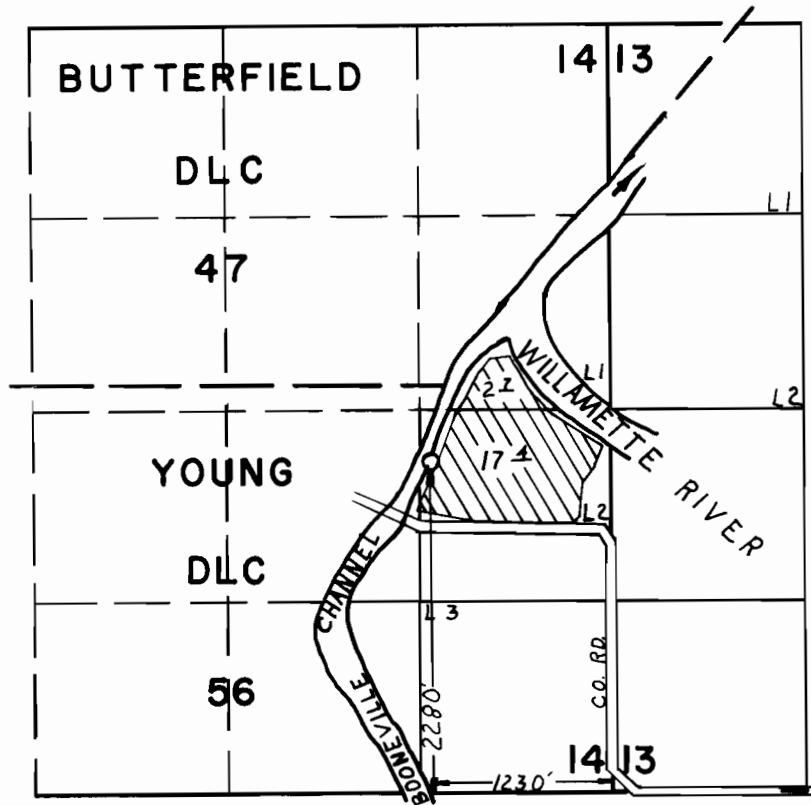

FINAL PROOF SURVEY
UNDER

Application No. 51139... Permit No. 38655..
IN NAME OF

.....ALBERT A. WILT.....

Surveyed APR. 23. 1976, by G.R. KING.....