


T.12S., R.6W., W.M.

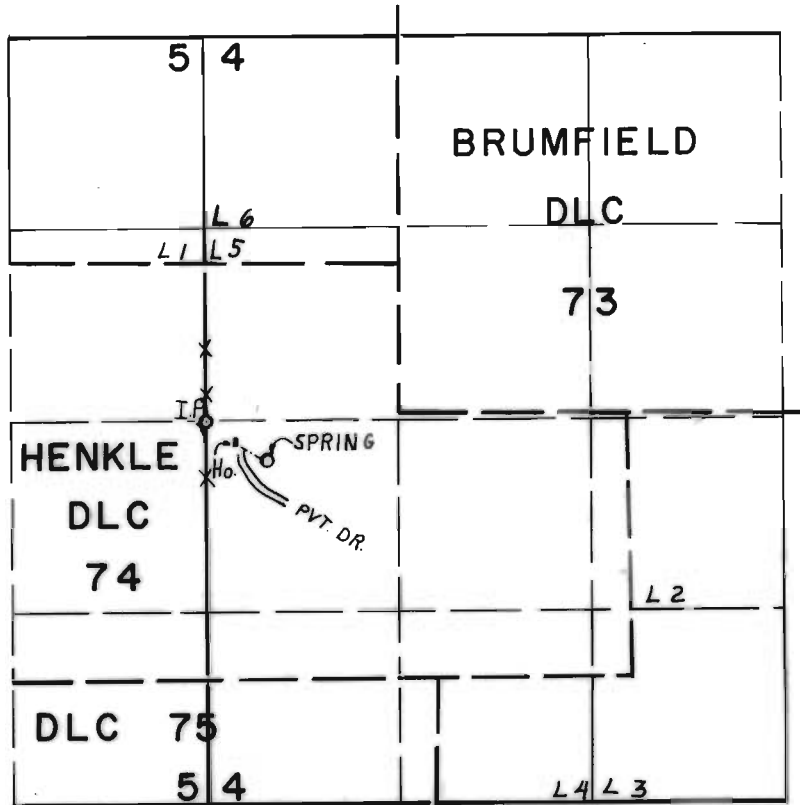

DIV: 250'S & 420'E FROM W 1/4 COR SEC 4 W/ DLC 74

FINAL PROOF SURVEY
UNDER

Application No. 51596 Permit No. 38918
IN NAME OF

STEPHEN F. & MARGARET HAMM

Surveyed APR. 16, 1976, by C.R. KING