


T.12S., R.4W. W.M.

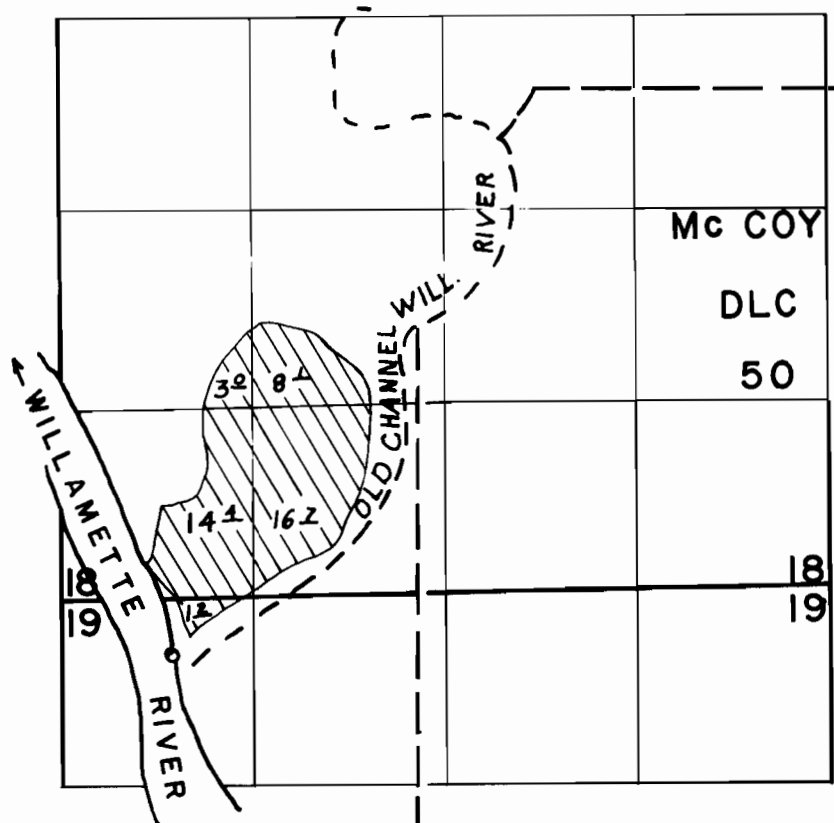

DIV. 400'S & 750'E FROM NW COR. SEC 19

FINAL PROOF SURVEY
UNDER

Application No. 51783 Permit No. 39013
IN NAME OF

JACOB ROHNER

Surveyed OCT. 4 1976, by G.R. KING