


T.12S.,R.5W.,W.M.

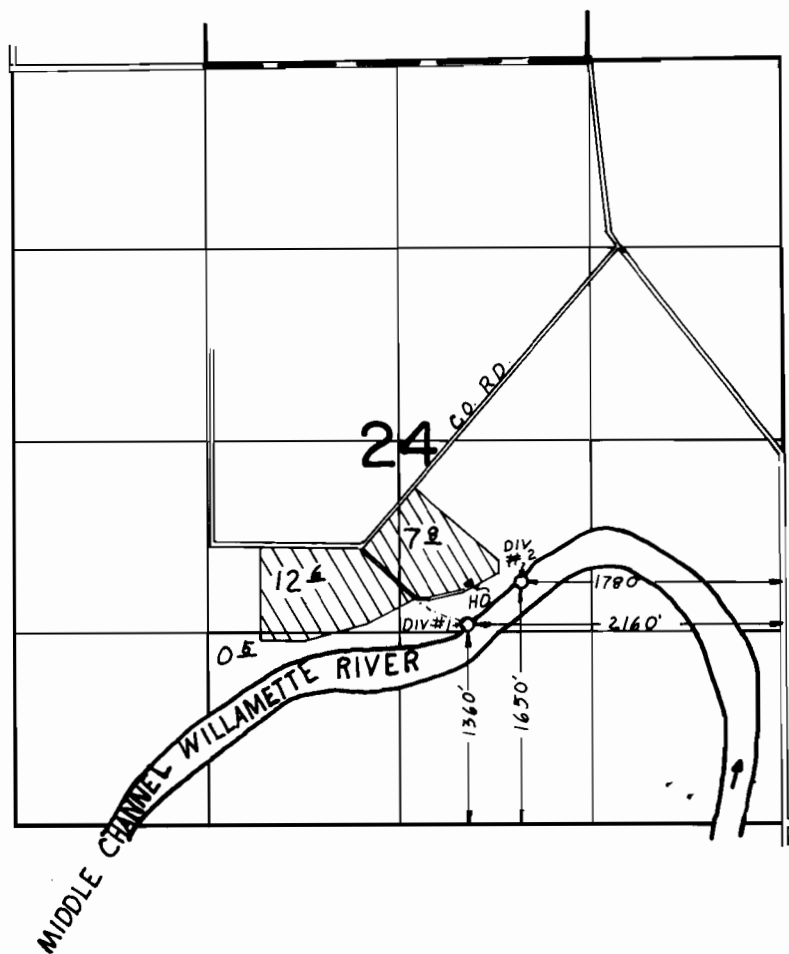

FINAL PROOF SURVEY
UNDER

Application No. 52260. Permit No. 39329.
IN NAME OF

LESLIE & MARGARET WHEELER

Surveyed JULY 7, 1976, by C.R. KING.....