


T.8N.,R.10W.,W.M.

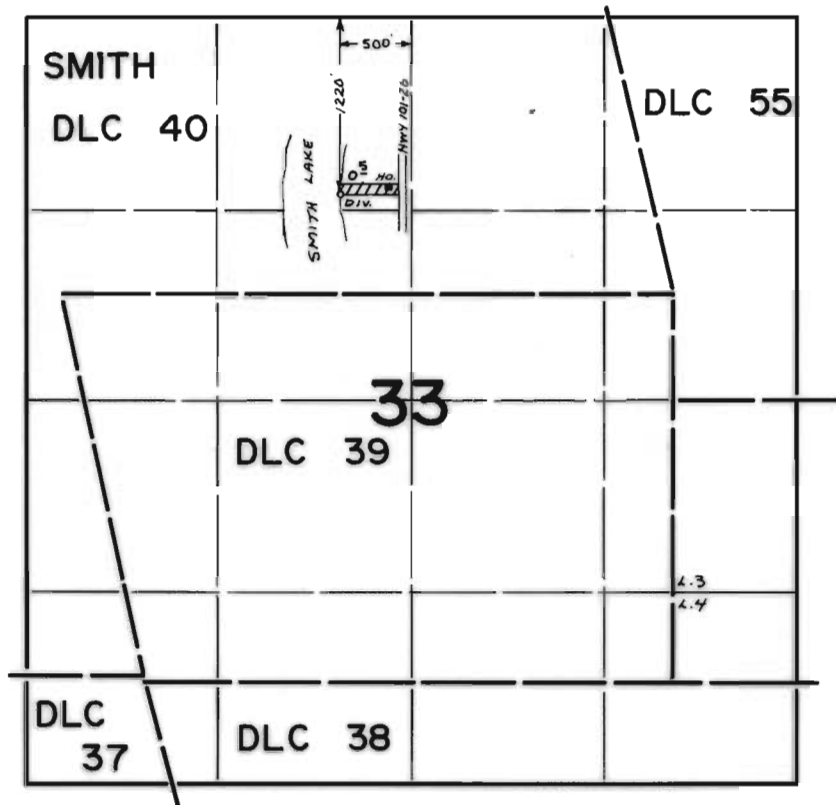

FINAL PROOF SURVEY
UNDER

Application No. 47729 Permit No. 35752
IN NAME OF

ARTHUR S. CAPLES

Surveyed JUNE 24 1976, by L. TOLL