


T.8N.,R.8W.,W.M.

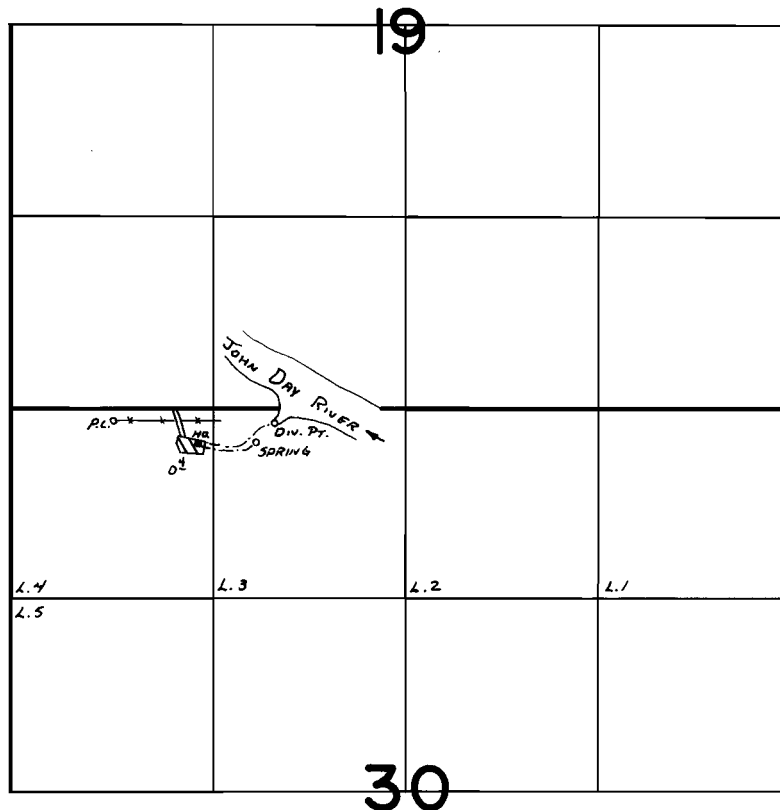

RIVER DIV: 100' S AND 1810' E FROM NW COR. SEC 30
SPRING: 230' S AND 1680' E FROM NW COR. SEC 30

FINAL PROOF SURVEY
UNDER

Application No. 48287 Permit No. 35961
IN NAME OF

THOMAS L. & DELLA GRAY

Surveyed JUNE 21, 1976, by L. TOLL