


T.8N.,R.10W.,W.M.

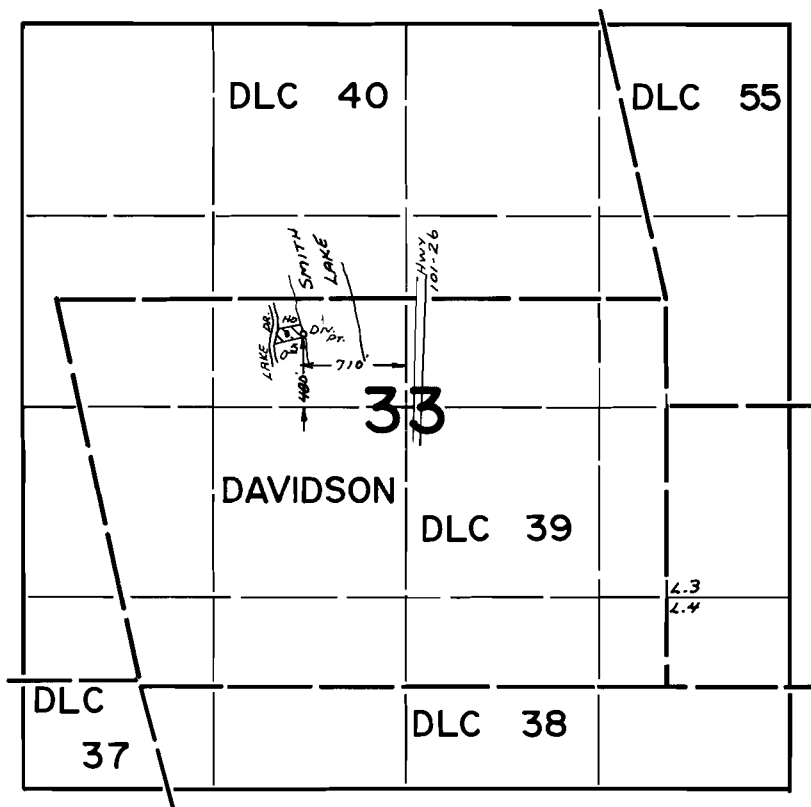

FINAL PROOF SURVEY
UNDER

Application No. 50160 Permit No. 37682
IN NAME OF

SIGFRED C. & JUANITA R. JENSEN

Surveyed JUNE 24 1976, by L. TOLL