


T.8N.,R.10W.,W.M

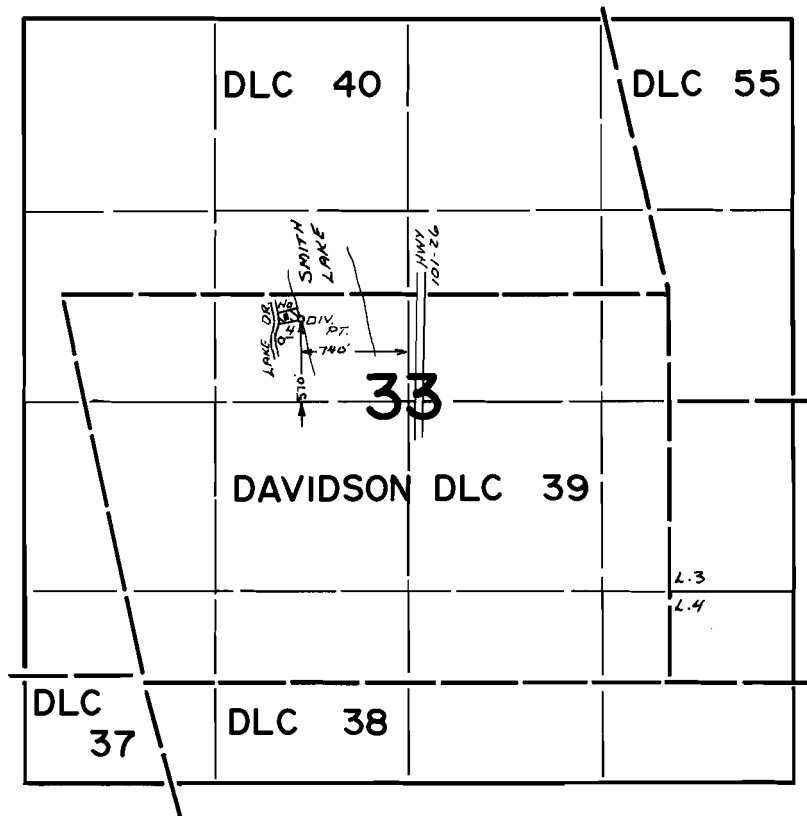

FINAL PROOF SURVEY
UNDER

Application No. 50166... Permit No. 37685..
IN NAME OF

CECIL R. BOTKIN

Surveyed JUNE 24 1976, by L. T. TOL