


T.23S.,R.12W.,W.M.

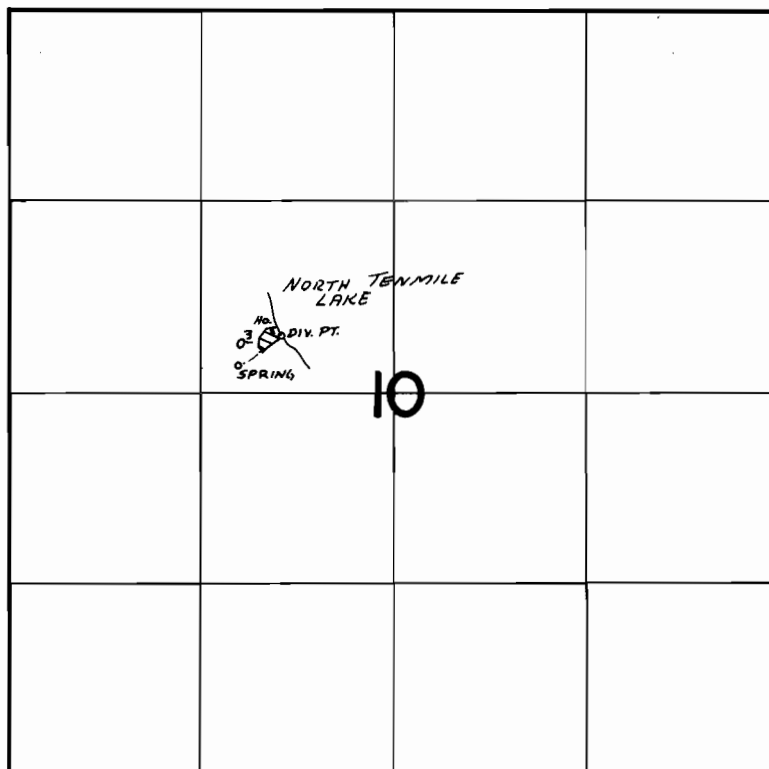

SPRING LOC: 180' N AND 260' E; LAKE DIV: 390' N AND 550' E
BOTH FROM SW COR SE 1/4 NW 1/4 SEC 10

FINAL PROOF SURVEY
UNDER

Application No. 51836... Permit No. 39144...
IN NAME OF

LEON B. VAN NORTWICK

Surveyed MAY 26, 1976, by L. TOLL