


T.28S.R.10W.W.W.

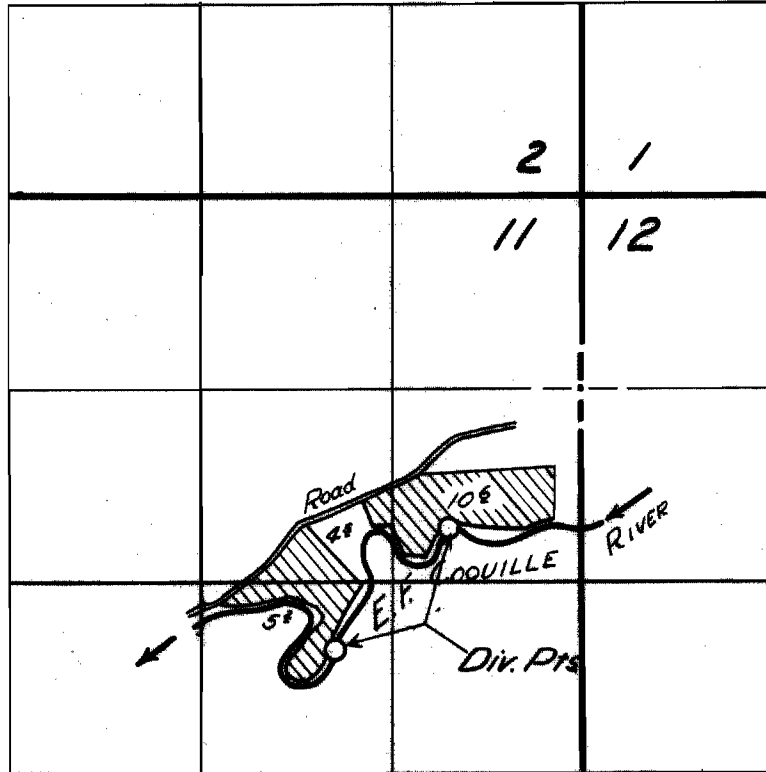

FINAL PROOF SURVEY

UNDER

Application No. 22620 Permit No. 17789

IN NAME OF

IVAN C. LAIRD

Surveyed 19 Mar. 1955, by T. JONES

1955-Y