


T28SR12WWM

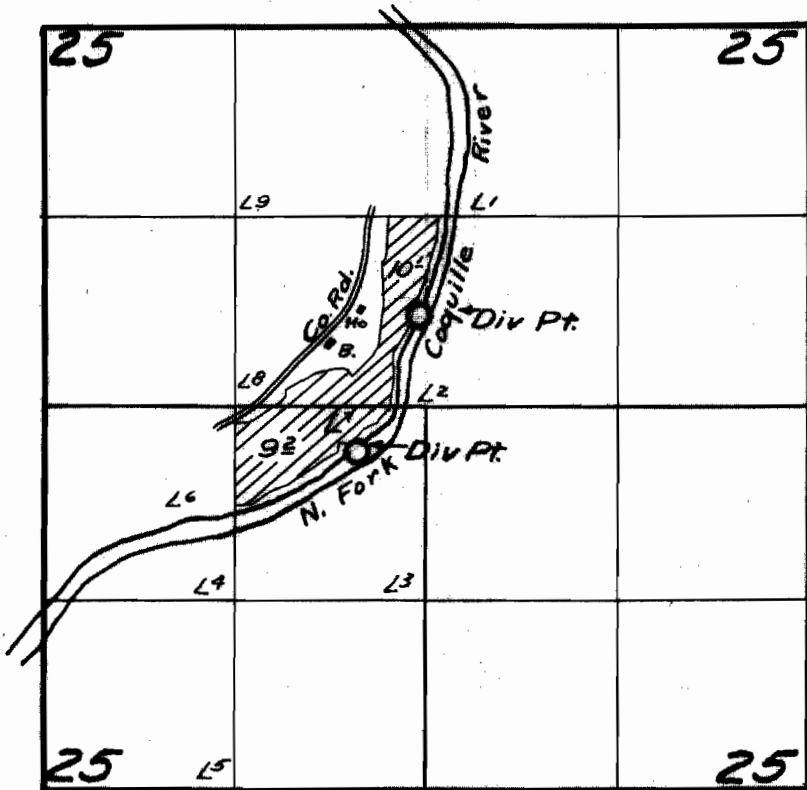

FINAL PROOF SURVEY
UNDER

Application No. 22684 Permit No. 17840
IN NAME OF

RAY A. HOOVER

Surveyed Aug 9 1955, by M. Bish