


T.32 & 33S. R.7W. W.M.

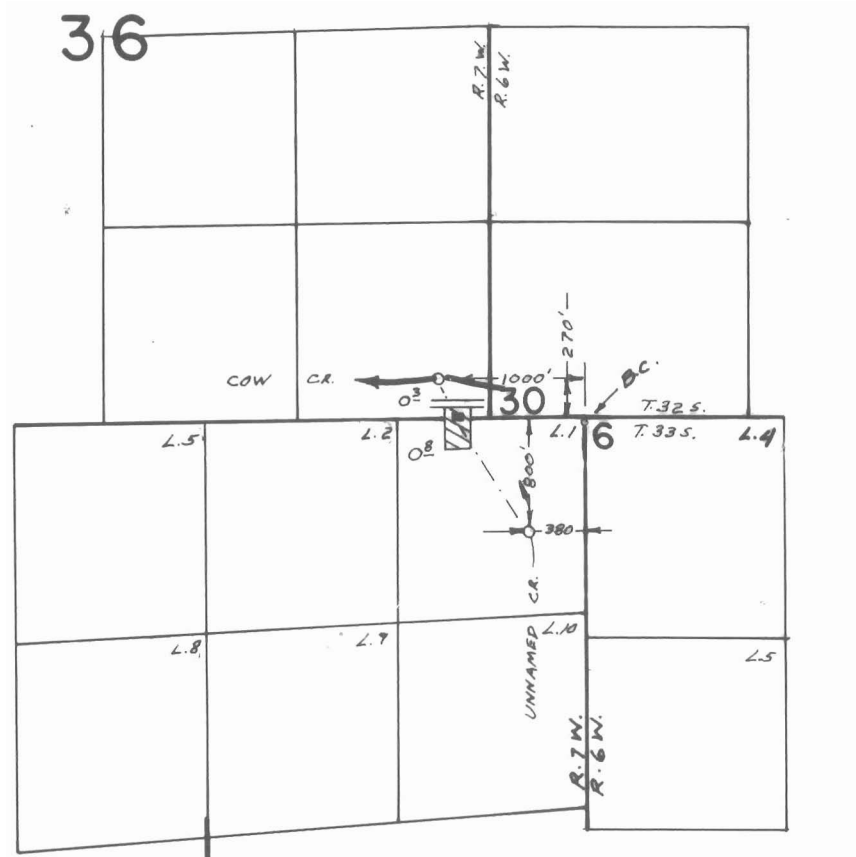

FINAL PROOF SURVEY
UNDER

Application No. 46849.... Permit No. 35031.....
IN NAME OF

.....HOMER TOOLEY.....

Surveyed APR. 14. 1977, by L.E. GOULD.....