


T.32S. R.5W. W.M.

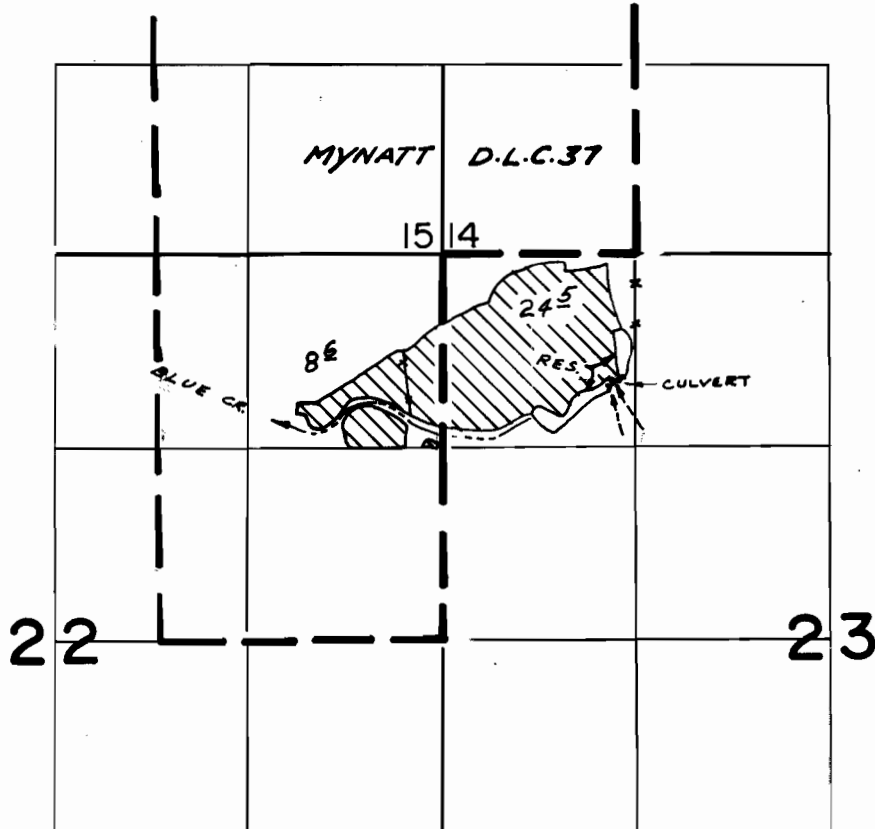

W. RES. LOC. 1130'S. & 710'W. E. RES. LOC. 860'S. & 120'W.; BOTH FROM NE COR., NW 1/4 NW 1/4, SEC. 23.

FINAL PROOF SURVEY
UNDER

R-47089 R-5909
Application No. 47090..... Permit No. 36541.....
IN NAME OF

.....KENNETH L. BRADY.....

Surveyed JUL. 15. 1976., by L.H. NUNN.....