


T.27S. R.7W. W.M.

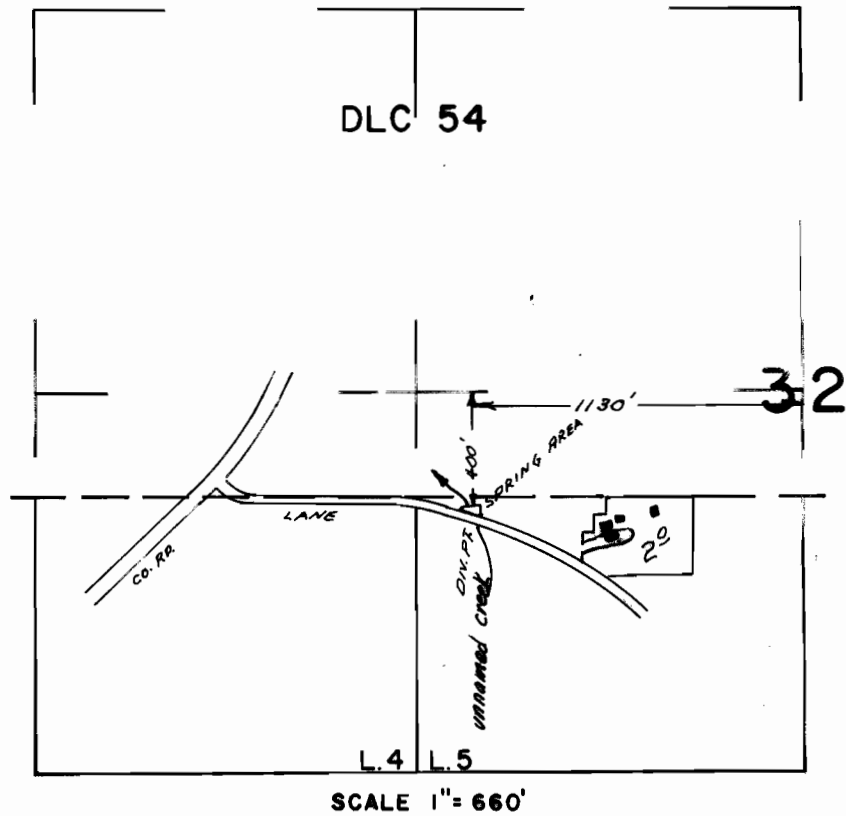

FINAL PROOF SURVEY
UNDER

Application No. 48281..... Permit No. 36238...
IN NAME OF

.....ROBERT E. KYLE.....

Surveyed FEB. 22. 1978, by D.W. SPARKS.....
JUL. 30 1976 L.E. GOULD