


T.22S.R.5W.W.M.

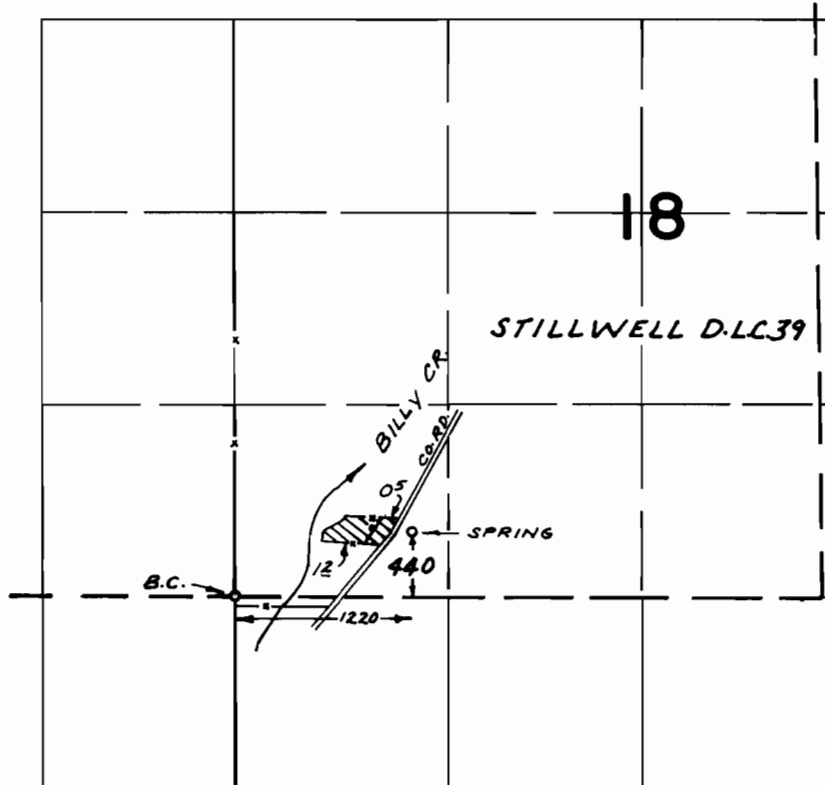

FINAL PROOF SURVEY
UNDER

Application No. 48349 Permit No. 36302
IN NAME OF

MYRTLE McNABB

Surveyed MAY 25 1976, by R. MUCKEN