


T.22S.R.5W.W.M.

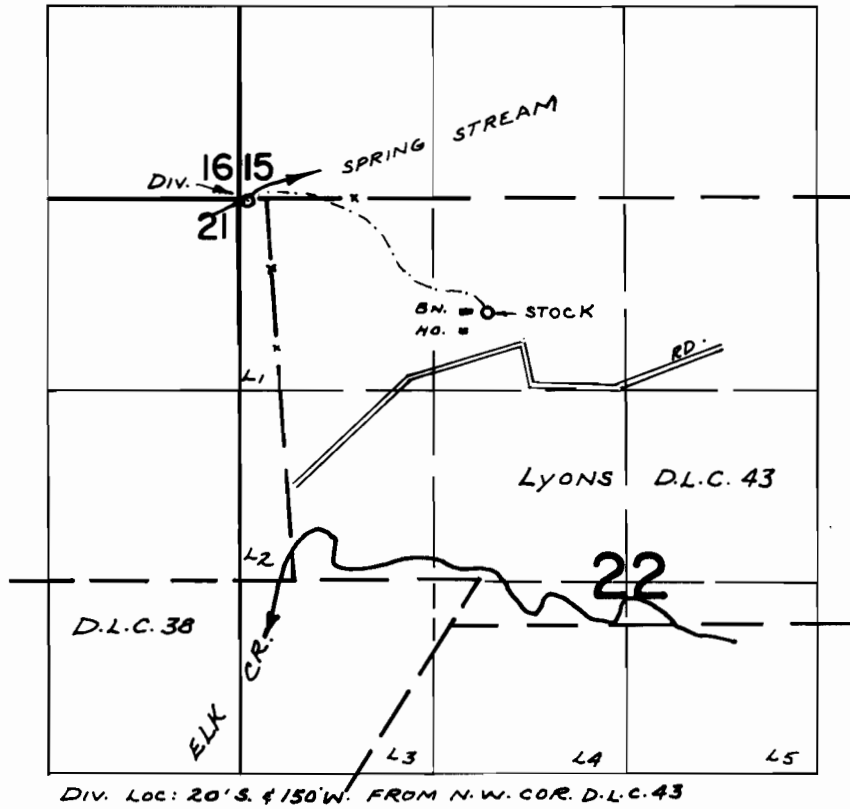

FINAL PROOF SURVEY UNDER

Application No. 48461 Permit No. 36373
IN NAME OF

CHARLES A. BASS & JOHN L. BELL

Surveyed MAY 10, 1976, by R. MUCKEN