


T.30S. R.5W. W.M.

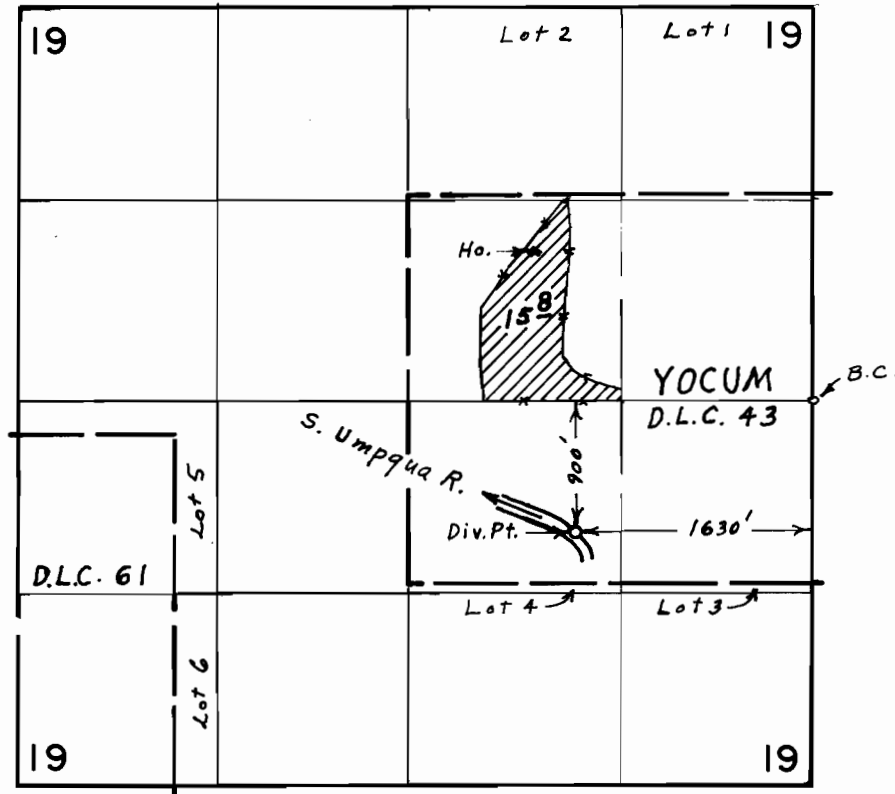

FINAL PROOF SURVEY
UNDER

Application No. 48495.. Permit No. 36389..
IN NAME OF

MILTON HERBERT

Surveyed April 6, 1976, by L. E. Gould.