


T.29S. R.6W. W.M.

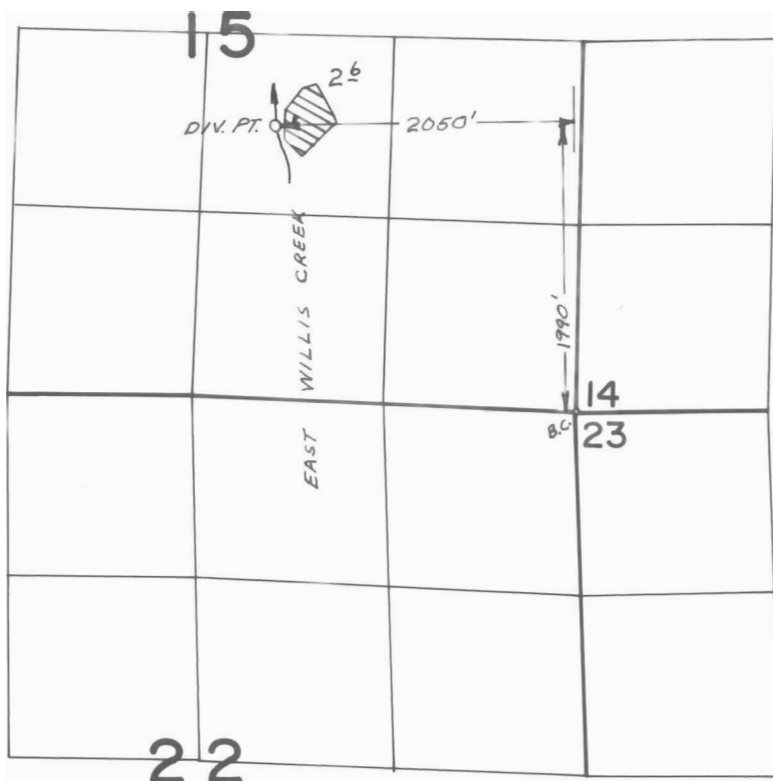

FINAL PROOF SURVEY
UNDER

Application No. 49553 Permit No. 37090
IN NAME OF

MELTON & ETTA EDMUNSON
& DANIEL & BECKY KERSCH
Surveyed OCT. 6 1976, by L.H. NUNN