


# T.30S. R.6W. W.M.

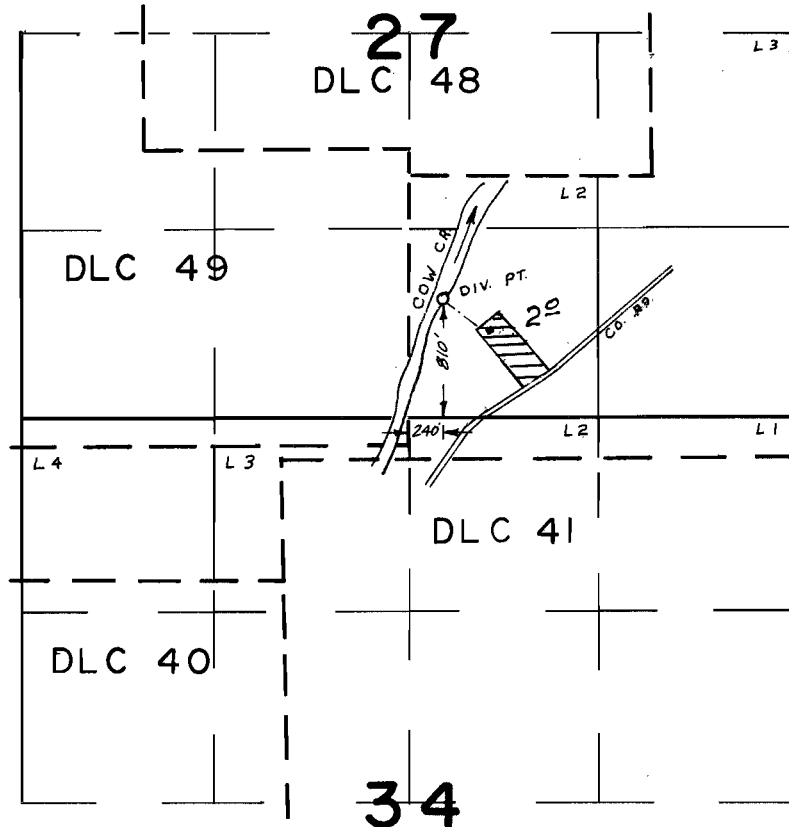

## FINAL PROOF SURVEY UNDER

Application No. 49932 Permit No. 37578  
IN NAME OF

VICTOR M. MEJIA

Surveyed OCT. 22, 1975, by L.H. NUNN  
OCT. 8, 1976 BY L.H. NUNN