


T.22S.,R.8W.,W.M.

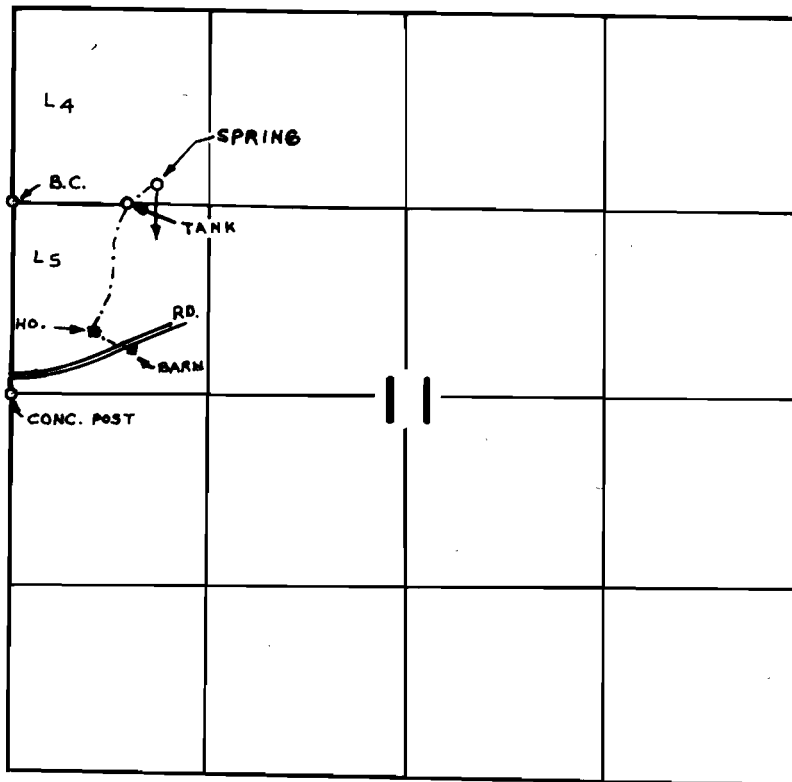

SPRING LOC. - 130' N. & 1000' E. FROM S.W. COR. N.W. 1/4 N.W. 1/4

FINAL PROOF SURVEY
UNDER

Application No. 50072... Permit No. 37630...
IN NAME OF

WILLIAM R. ARSENAULT

Surveyed May 12, 1976, by R.G. Mucken...