


T.27S. R.7W. WM.

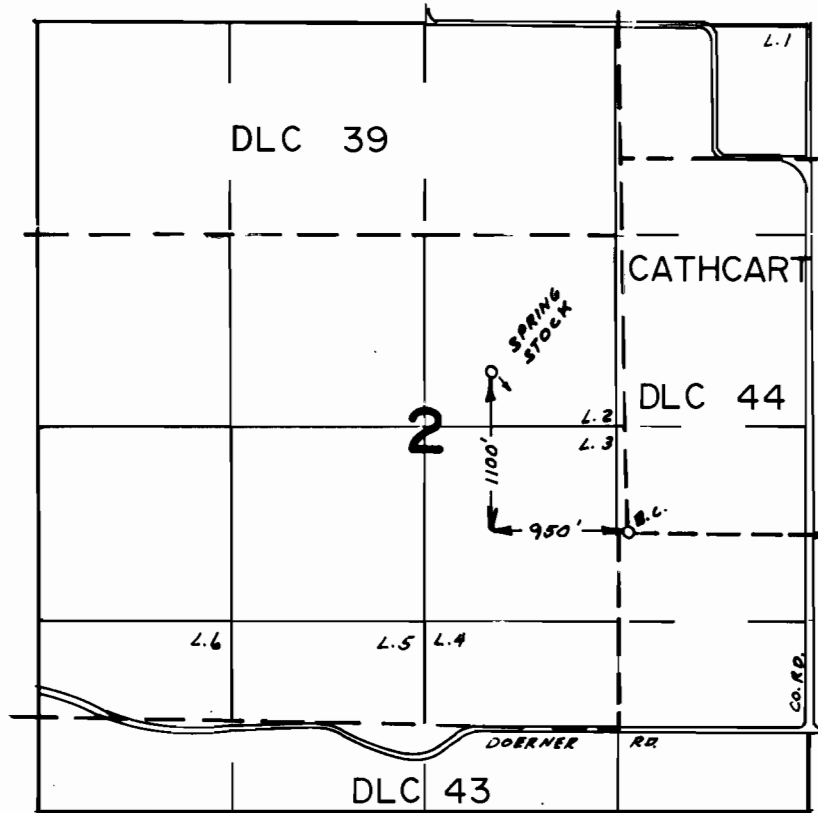

FINAL PROOF SURVEY
UNDER

Application No. 50105 Permit No. 37918
IN NAME OF

..... PAUL A. BACKLUND

Surveyed APR. 8. 1976, by L.H. NUNN