


T.22S.,R.11W.,W.M.

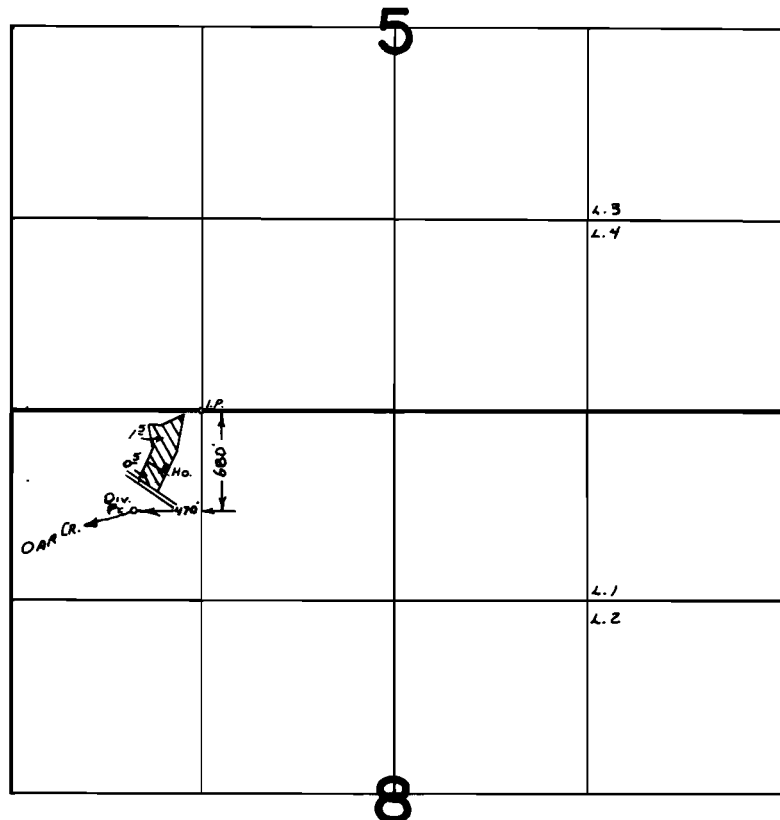

FINAL PROOF SURVEY
UNDER

Application No. 50121 Permit No. 37663
IN NAME OF

HARRY ROBERT WILKES

Surveyed MAY 24 1976, by L. TOLL