


T.24S., R.7W., W.M.

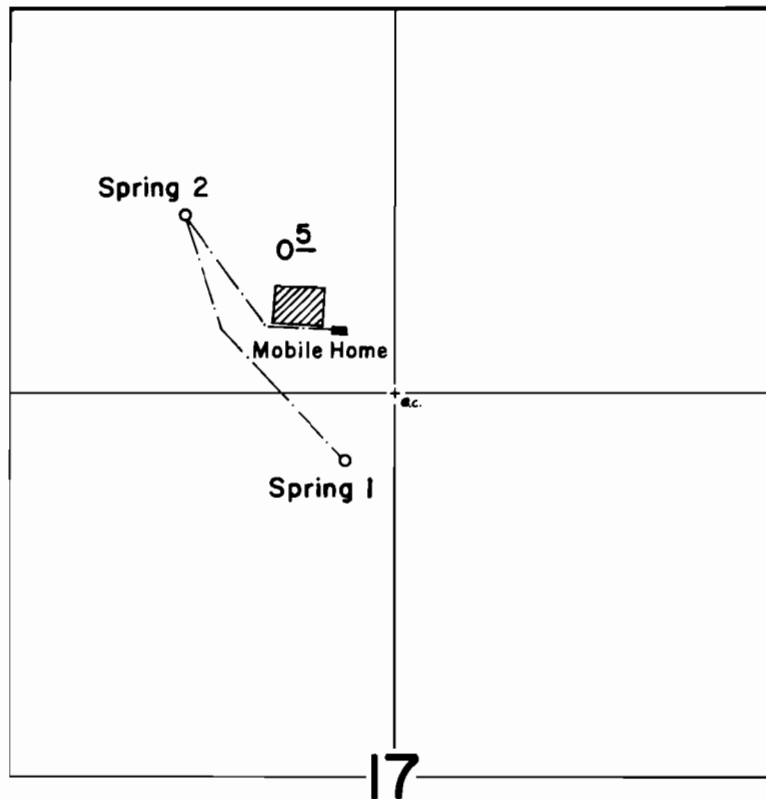

SPRINGS LOC: 1 - 230' S & 170' W; 2 - 610' N & 720' W BOTH FROM SE COR
NE 1/4 NW 1/4 SEC. 17

Scale: 1" = 660'

FINAL PROOF SURVEY
UNDER

Application No. 48866 Permit No. 36614
IN NAME OF

GALE E. STEELE

Surveyed July 28 1976, by D. Norby