


# T.28S., R.8W., W.M.

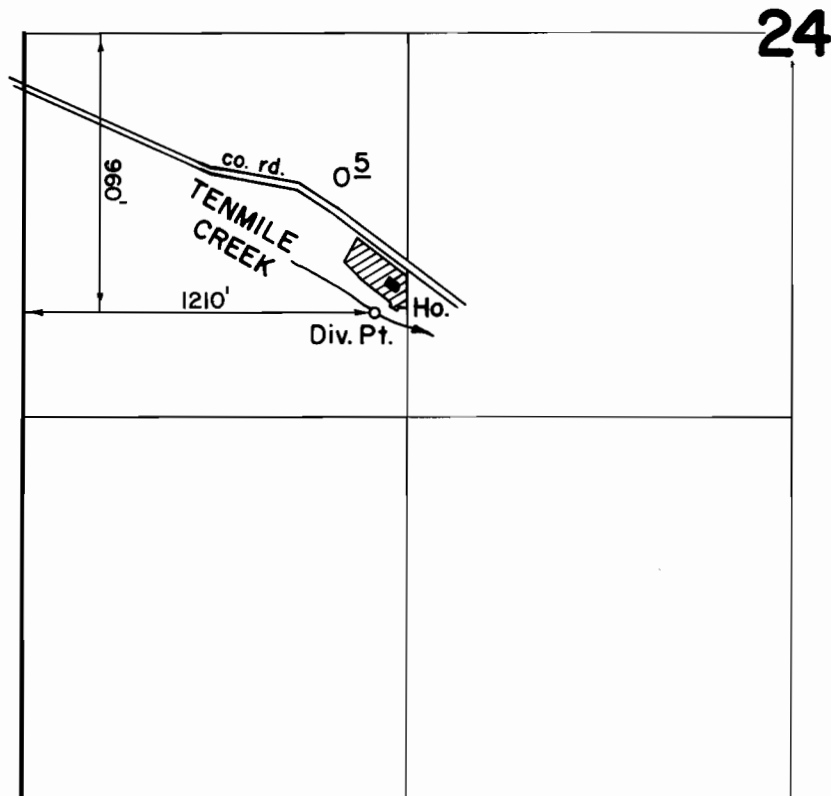

Scale: 1" = 660'

## FINAL PROOF SURVEY UNDER

Application No. 50357 Permit No. 38015  
IN NAME OF

MARTIN G. WENKS

Surveyed Oct. 13 1976, by D. Norby