


# T.22S.R.8 & 9W.W.M.

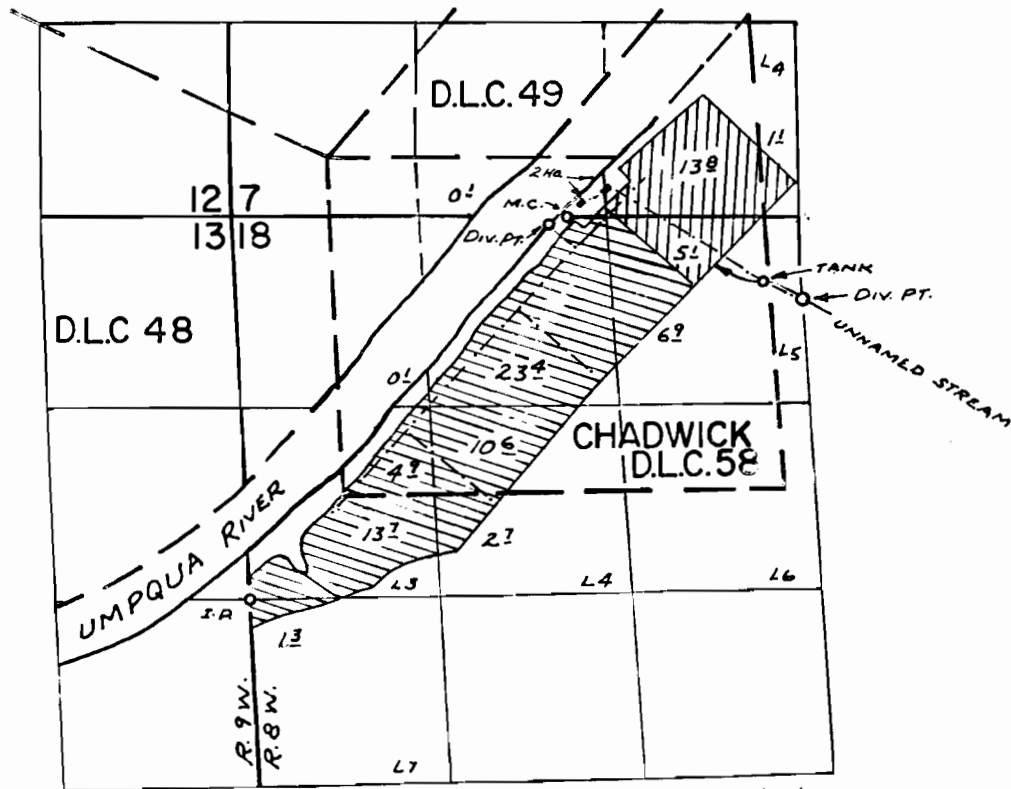

DIV. PTS. LOC: RIVER - 50'S. & 400'W ; UNN. STREAM - 580'S. & 1290'E. FROM N 1/2 COR. SEC. 18

## FINAL PROOF SURVEY UNDER

Application No. 53738..... Permit No. 40357.....  
50550..... 38166.....  
 IN NAME OF

.....FORREST.....SALOMON.....

Surveyed MAY 11 1976., by R. MUCKEN..