


T.26S., R.3W., W.M.

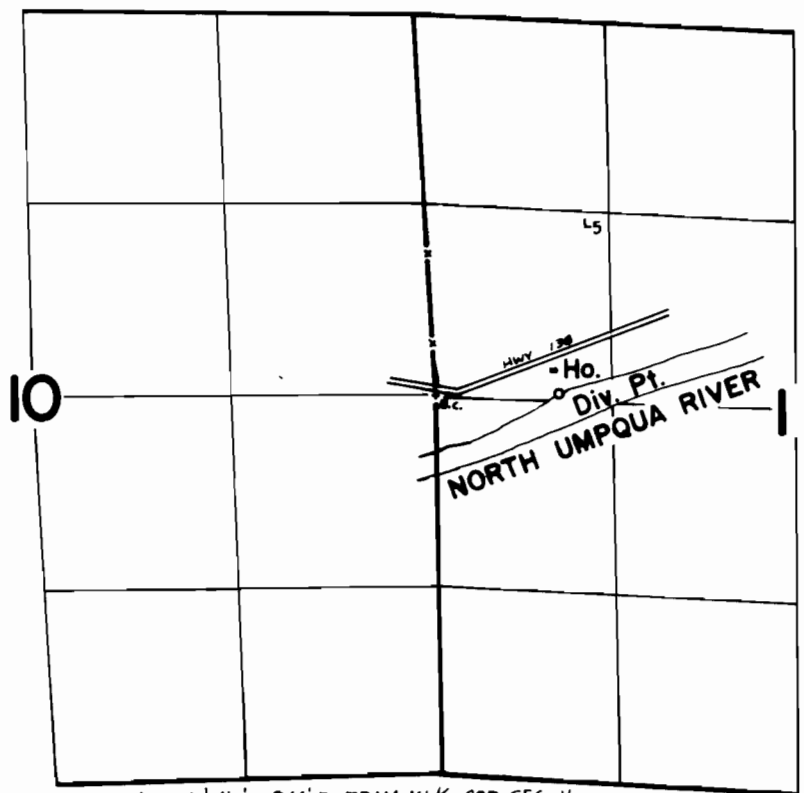

FINAL PROOF SURVEY
UNDER

Application No. 50604 Permit No. 38189
IN NAME OF

JAMES WALLACE

Surveyed April 7 1976, by D. Norby