


T.26S., R.4W., W.M.

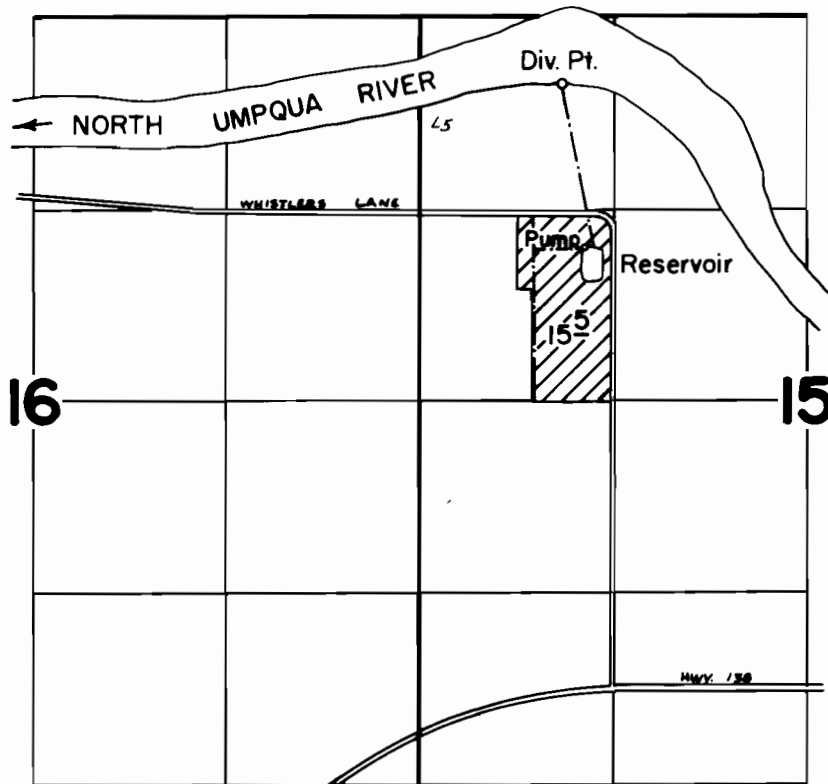

DIV. PTS. LOC: RIVER - 870' N & 350' W; RES. - 260' S & 200' W BOTH FROM NE COR. SW 1/4 NW 1/4 SEC. 15

FINAL PROOF SURVEY UNDER

Application No. R-50674 50675 Permit No. R-6182 38282

IN NAME OF
ROBERT & ROSE RILEY AND
ROBERT & KATHLEEN MOFFITT

Surveyed Sept. 2 1976, by D. Norby