


T.27S. R.6W. W.M.

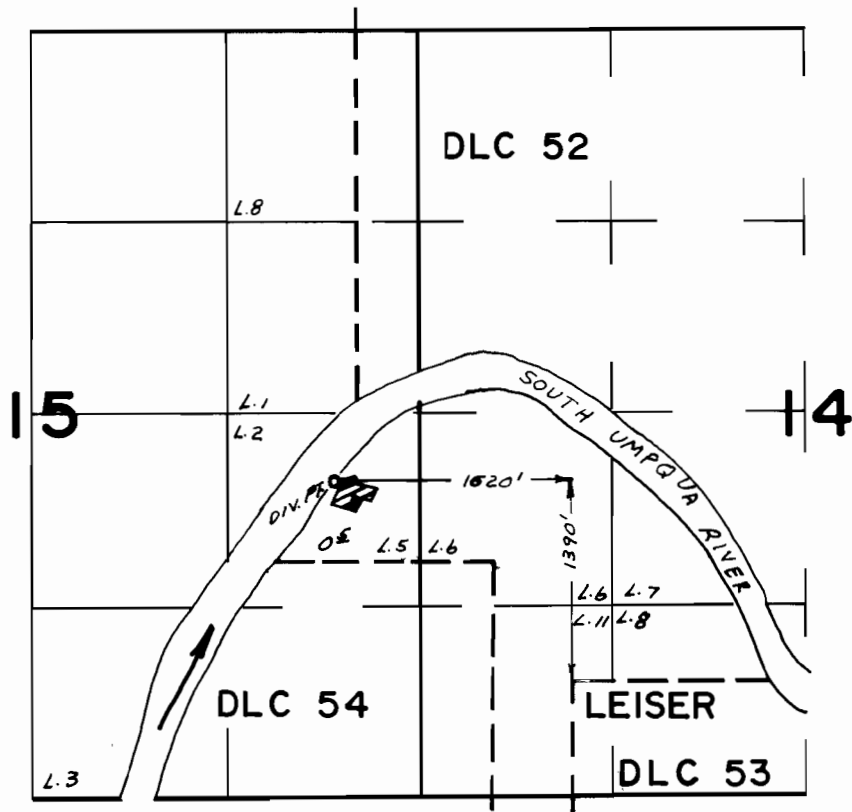

**FINAL PROOF SURVEY**  
UNDER

Application No. 50910..... Permit No. 38436....  
IN NAME OF

.....MICHAEL R. QUELLETTE.....

Surveyed SEP. 29. 1976., by L.H. NUNN.....