


T.27S. R.5W. W.M.

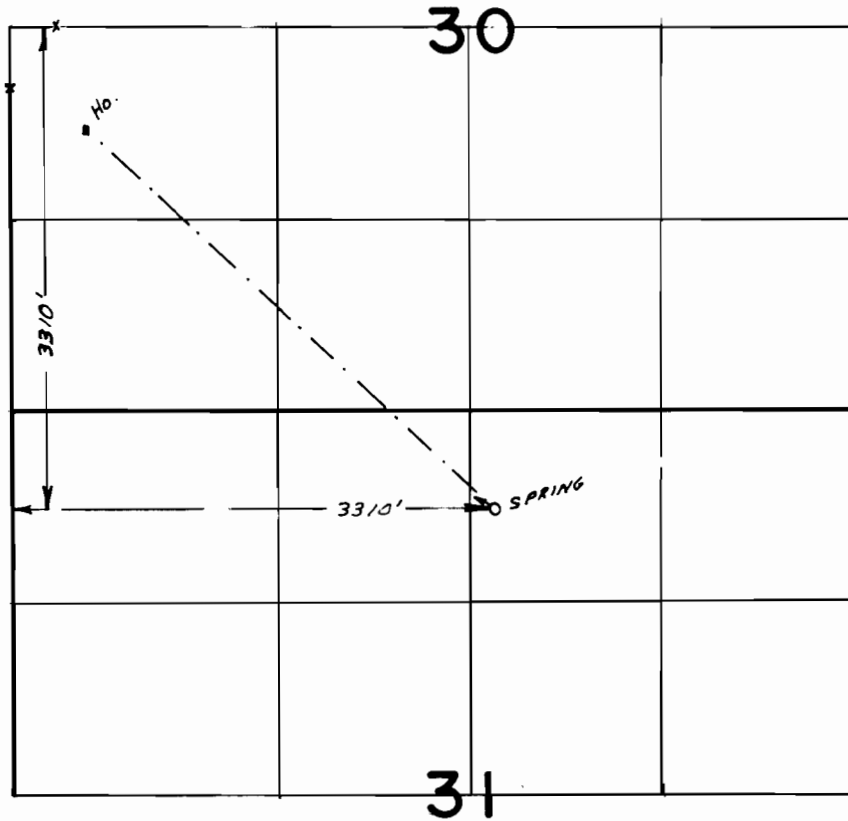

FINAL PROOF SURVEY
UNDER

Application No. 50927..... Permit No. 38449.....
IN NAME OF

..... PHILIP M. SHARPE

Surveyed SEP. 30. 1976., by L.H. NUNN.....