


T.27S. R.6W. W.M.

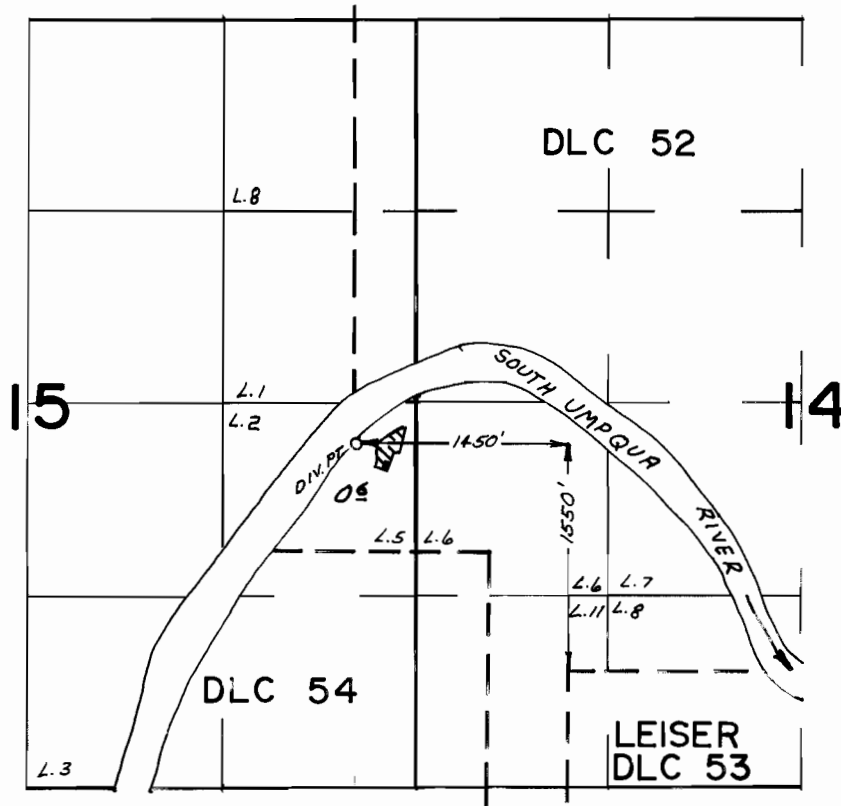

FINAL PROOF SURVEY
UNDER

Application No. 50935... Permit No. 38456
IN NAME OF

PAUL JORDAN ABEEL

Surveyed APR. 6. 1976, by L.H. NUNN