


T.30S. R.5W. W.M.

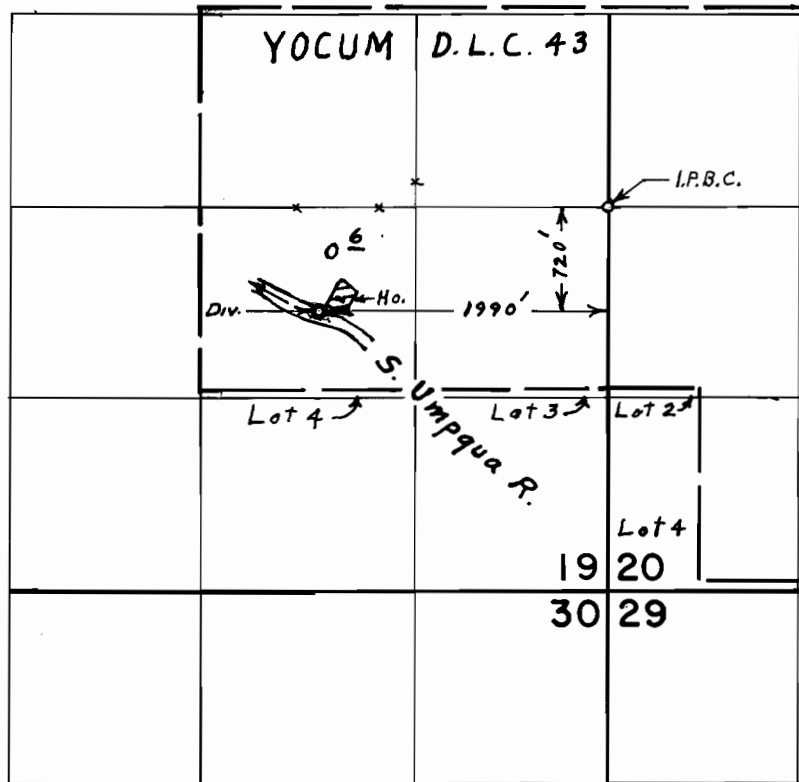

FINAL PROOF SURVEY UNDER

Application No. 50978 Permit No. 38479
IN NAME OF

DONALD M. & DONNA V. WELLS

Surveyed April 6, 1976, by L. E. Gould