


T.29S. R.5W. W.M.

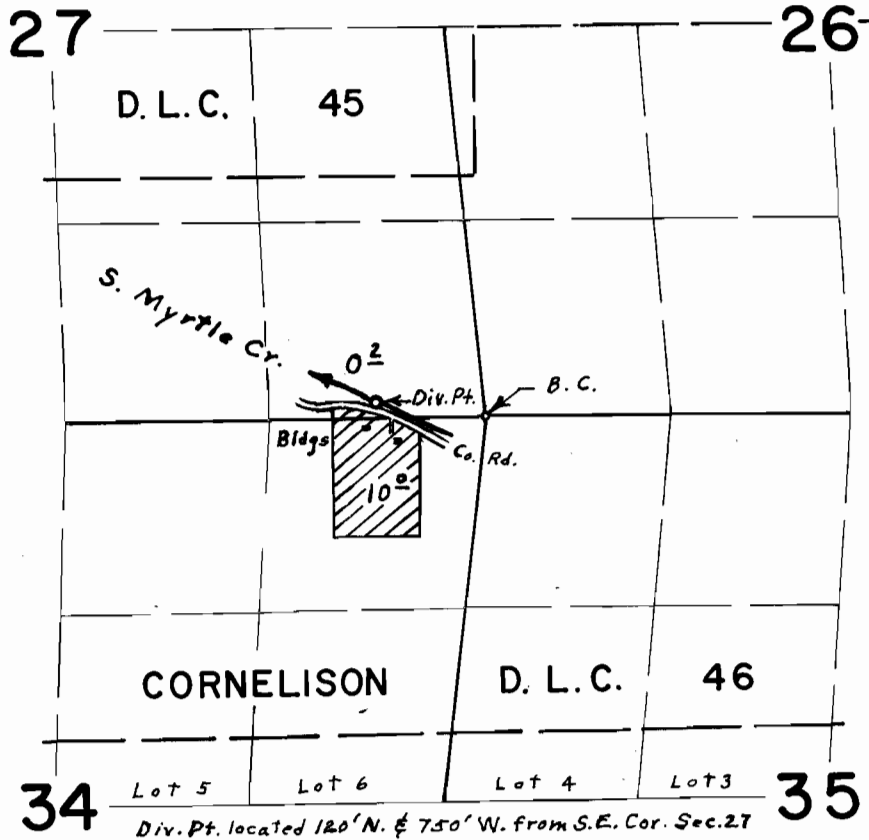

**FINAL PROOF SURVEY**  
UNDER

Application No. 50997 Permit No. 38492.  
IN NAME OF

W. ROLLAND EMMERSON

Surveyed May 24, 1976, by L. E. Gould