


T.21S.R.4W.W.M.

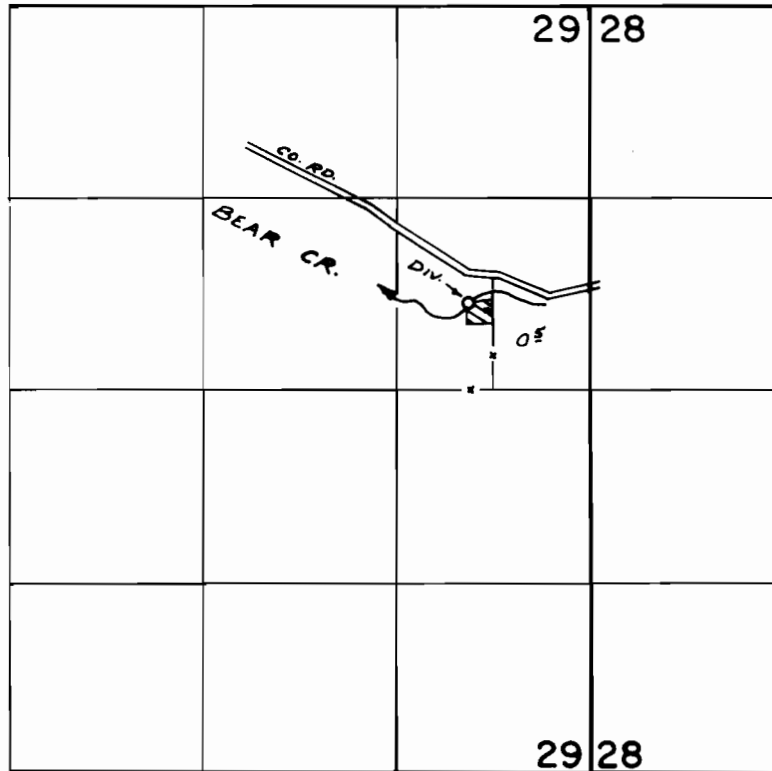

DIV. LOC: 580' N. & 480' E. FROM S.W. COR. SE 1/4 NE 1/4 SEC. 29

FINAL PROOF SURVEY UNDER

Application No. 51121 Permit No. 38643
IN NAME OF

HELEN SUITER

Surveyed MAY 25, 1976, by R. MUCKEN