


T.28S. R.6W. W.M.

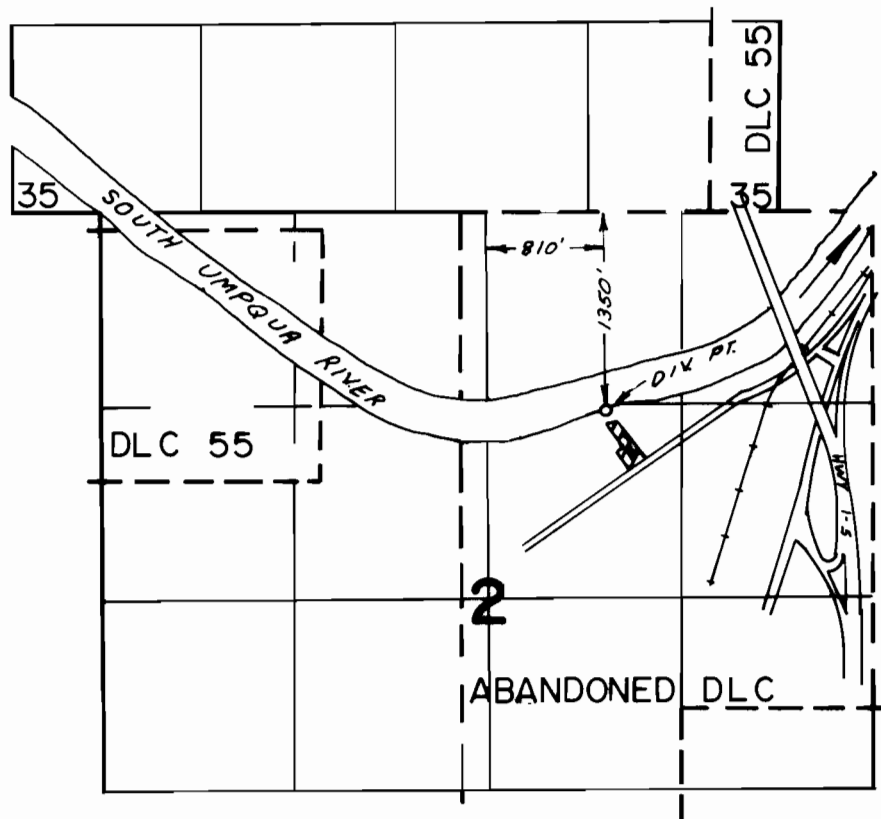

FINAL PROOF SURVEY UNDER

Application No. 51128..... Permit No. 38648...
IN NAME OF

.....RAYMOND R. OLSON.....

Surveyed APR. 7... 1976., by L.H. NUNN.....