


T.30S. R.5 W. W.M.

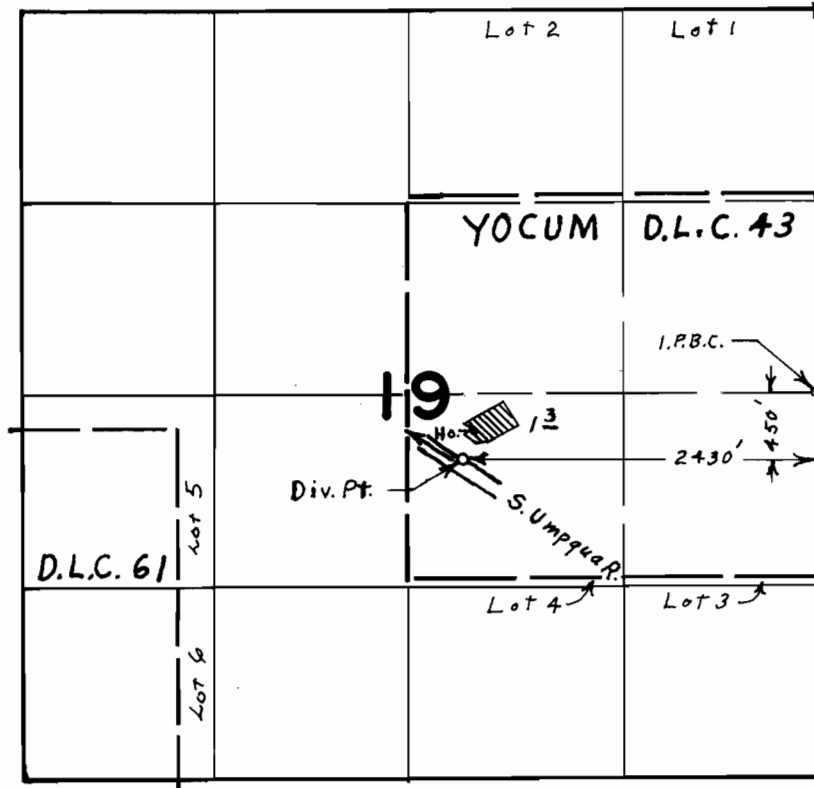

**FINAL PROOF SURVEY**  
UNDER

Application No. 51320 Permit No. 38749  
IN NAME OF

LOUISE E. COFFMAN

Surveyed April 6, 1976, by L. E. Gould