


T.23S., R.4W., W.M.

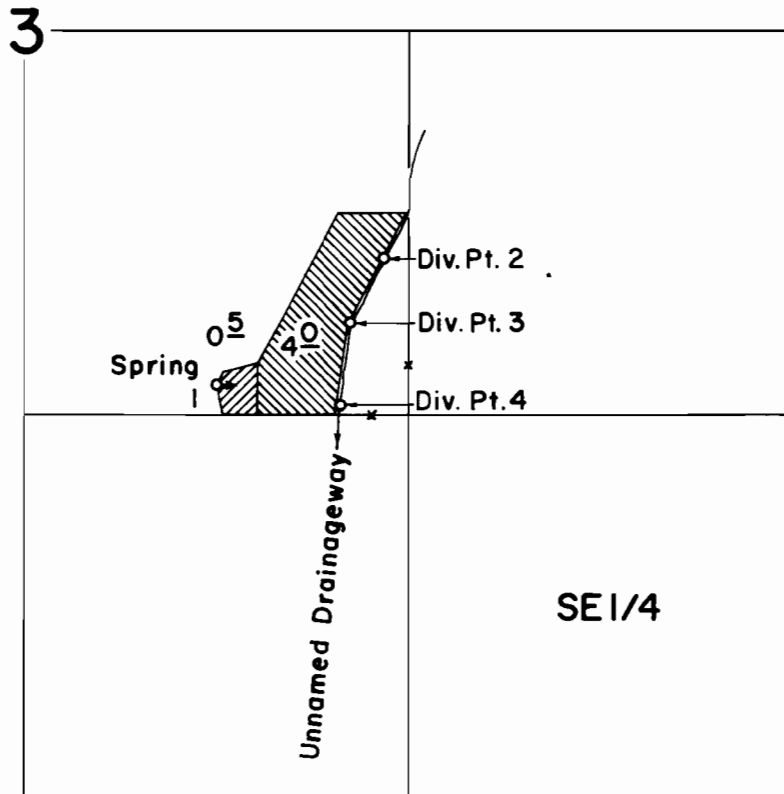

DIV. PTS. LOC: 1-100' N & 660' W; 2-540' N & 80' W; 3-320' N & 200' W;
4-30' N & 230' W; ALL FROM SE COR. NW 1/4 SE 1/4 SEC. 3.

Scale: 1" = 660'

 Spring
 Drainageway

FINAL PROOF SURVEY
UNDER

Application No. 51610 Permit No. 38927
IN NAME OF

HARRY NORRIS

Surveyed July 27 1976, by D. Norby