


T.25S., R.5W., W.M.

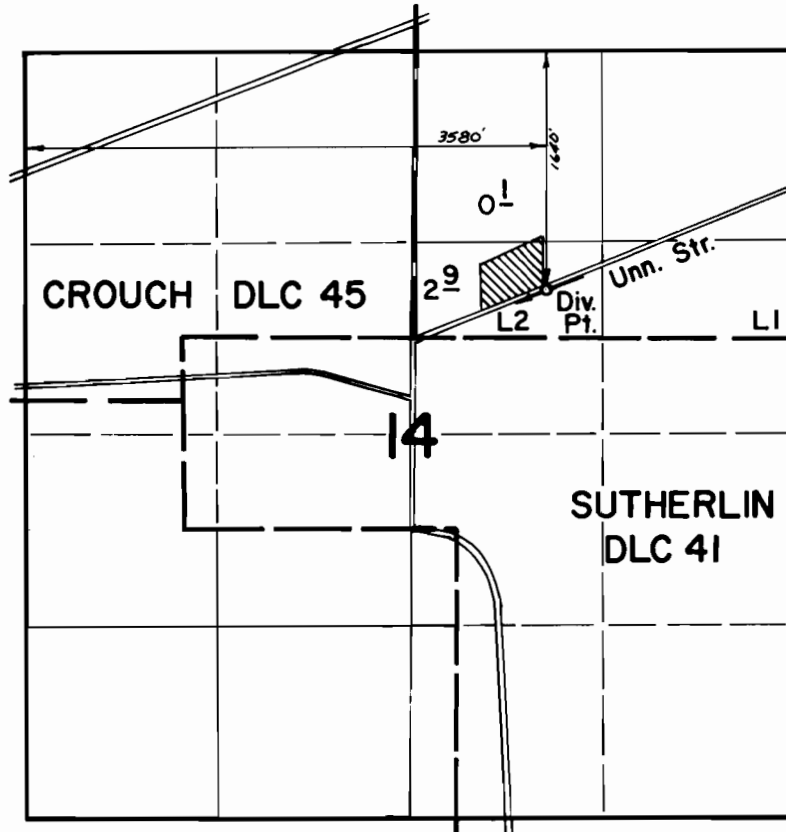

FINAL PROOF SURVEY
UNDER

Application No. 51665 Permit No. 38955
IN NAME OF

FRANKLYN R. HYATT

Surveyed July 30 1976, by D. Norby