


T.26S., R.3W., W.M.

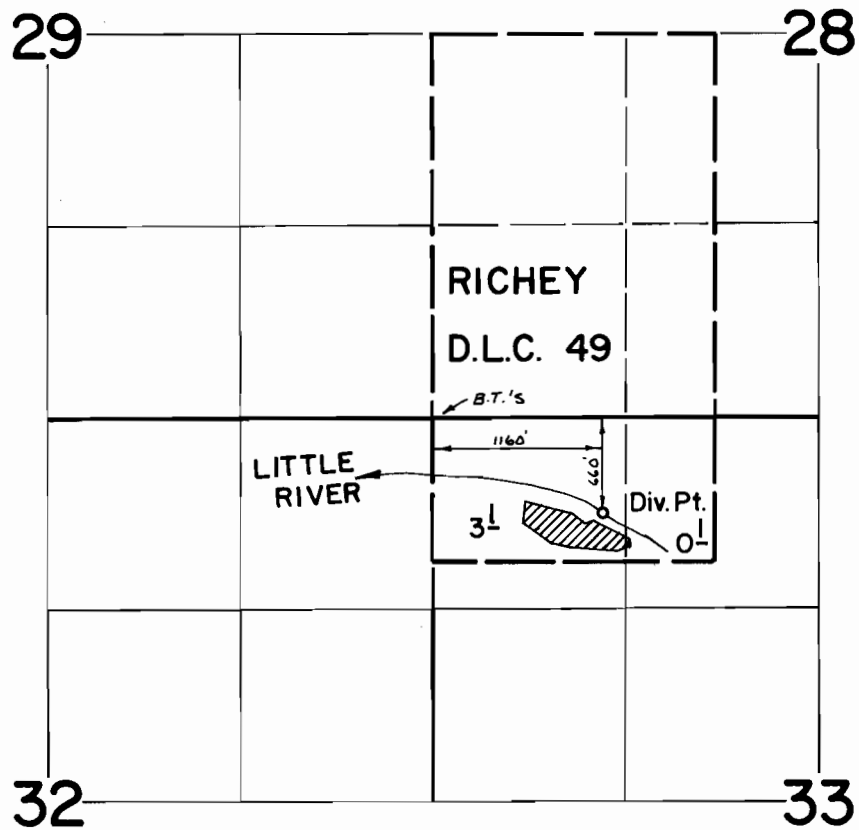

FINAL PROOF SURVEY
UNDER

Application No. 51695 Permit No. 38975
IN NAME OF

MRS. OLIVER P. STANDLEY

Surveyed Sept. 1 1976, by D. Norby