


T.26S., R.7W., W.M.

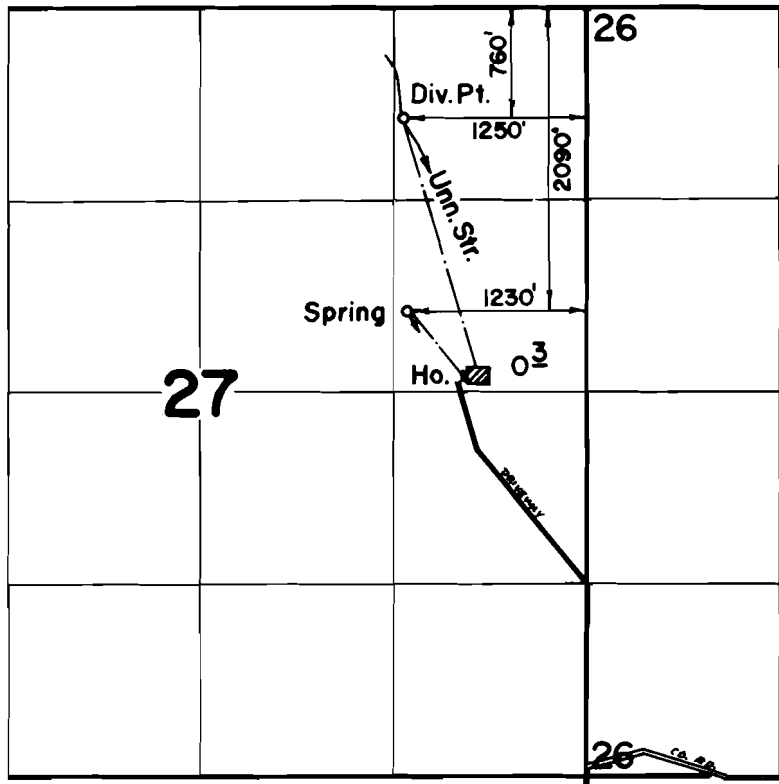

FINAL PROOF SURVEY
UNDER

Application No. 52189 Permit No. 39296
IN NAME OF

ROBERT D. HOLM

Surveyed Oct. 12 1976, by D. Norby