


T.29S. R.5W. W.M.

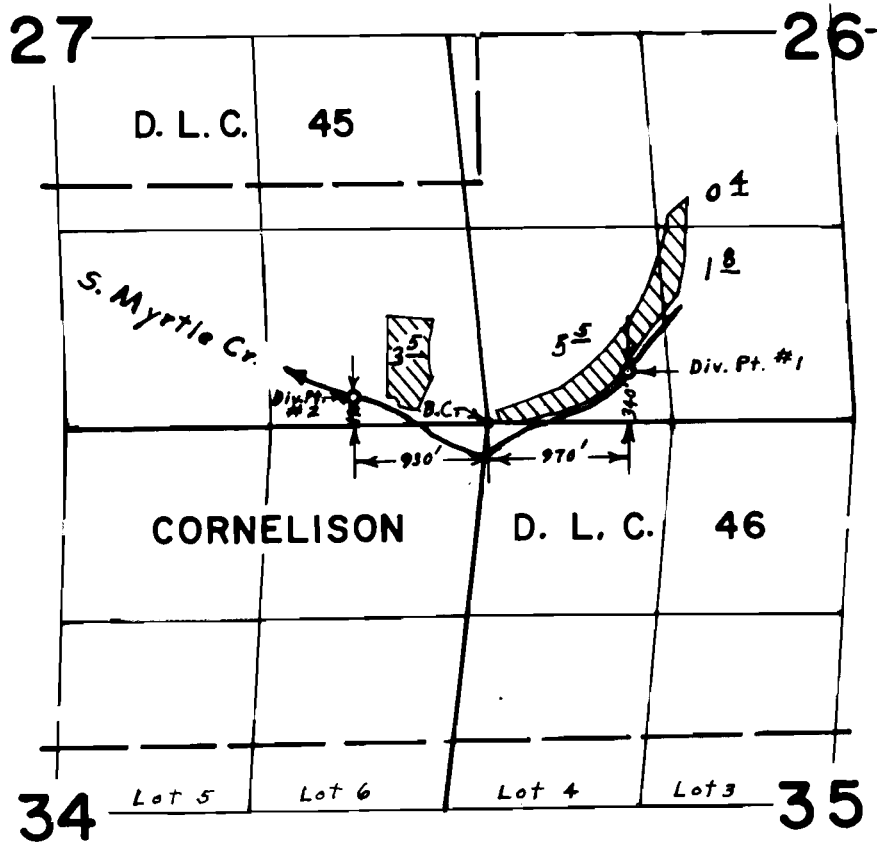

**FINAL PROOF SURVEY**  
UNDER

Application No. 52200. Permit No. 39305.  
IN NAME OF

**WILLIE P. MCFARLAND**

Surveyed May 28, 1976, by L. E. Gould.