


T.24S., R.7W., W.M.

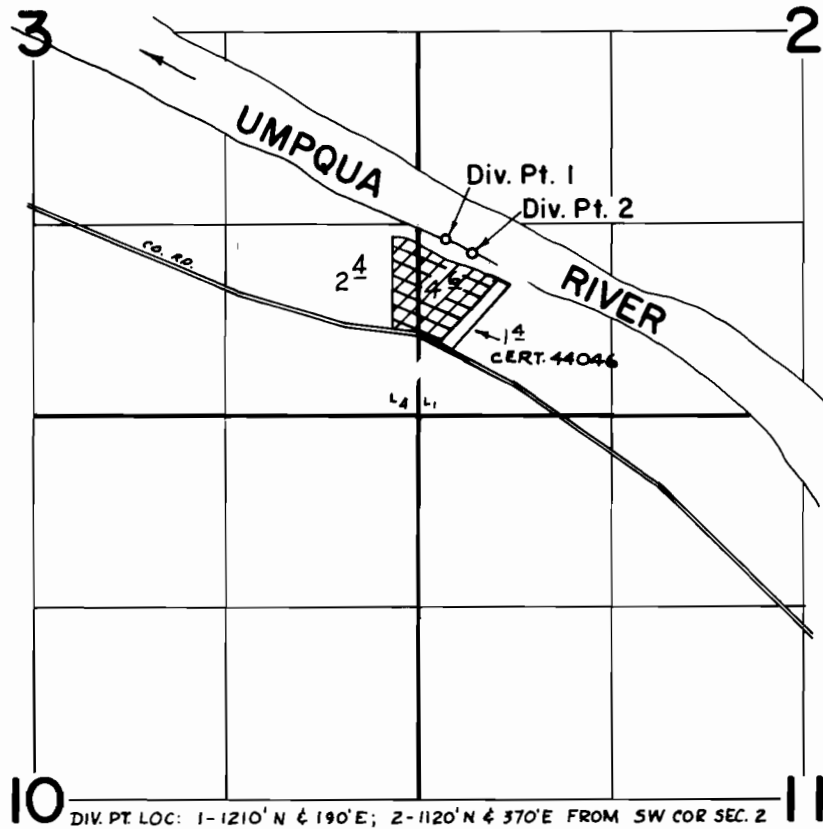

FINAL PROOF SURVEY
UNDER

Application No. 52699 Permit No. 39697
IN NAME OF

JOHN AND MOLLY STONE

Surveyed July 28 1976, by D. Norby