


T.26S., R.3W., W.M.

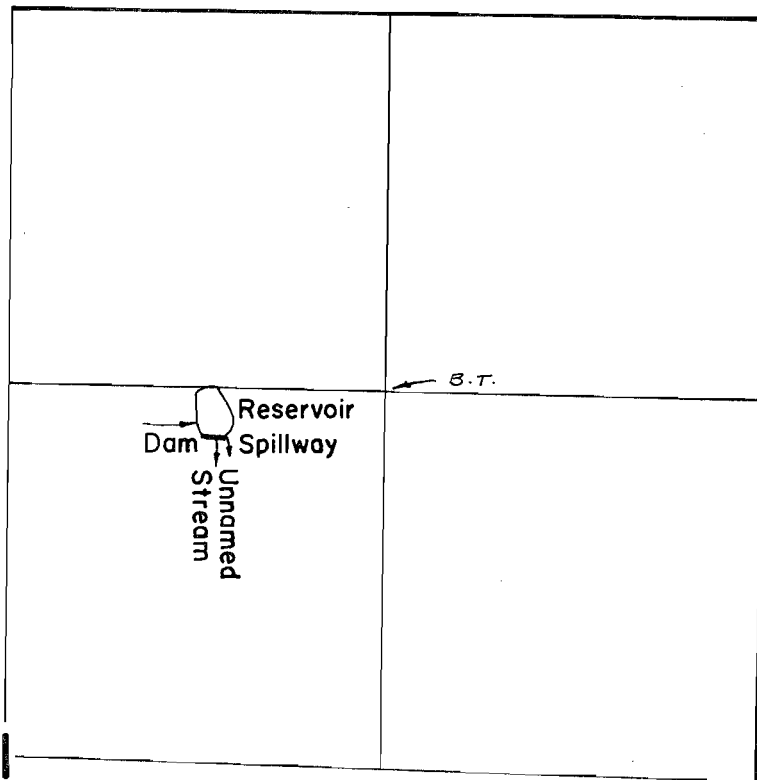

DAM LOC: 170' S & 580' W FROM NE COR. SW 1/4 NE 1/4 SEC. 1

Scale: 1" = 660'

FINAL PROOF SURVEY
UNDER

Application No. R-53263 Permit No. R-6346
53519 39598
IN NAME OF

KENNETH OVERTON

Surveyed Aug. 31 1976, by D. Norby