


T.26S., R.3W., W.M.

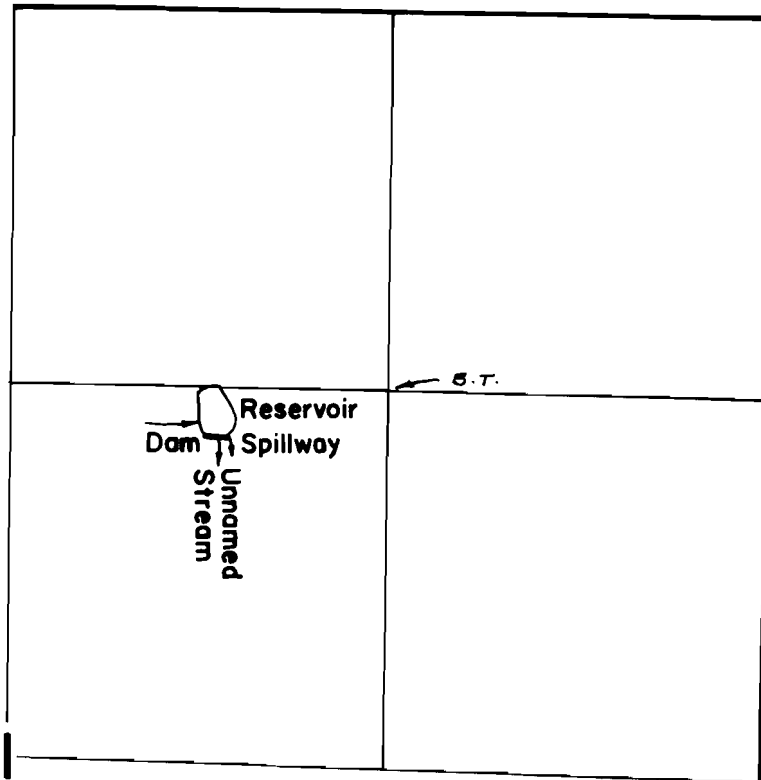

DAM LOC: 170' S & 500' W FROM NE COR. SW $\frac{1}{4}$ NE $\frac{1}{4}$ SEC. 1

Scale: 1" = 660'

FINAL PROOF SURVEY UNDER

Application No. R-53263 53519 Permit No. R-6346 39598
IN NAME OF

KENNETH OVERTON

Surveyed Aug. 31 1976, by D. Norby