


T.26S. R.5W. W.M.

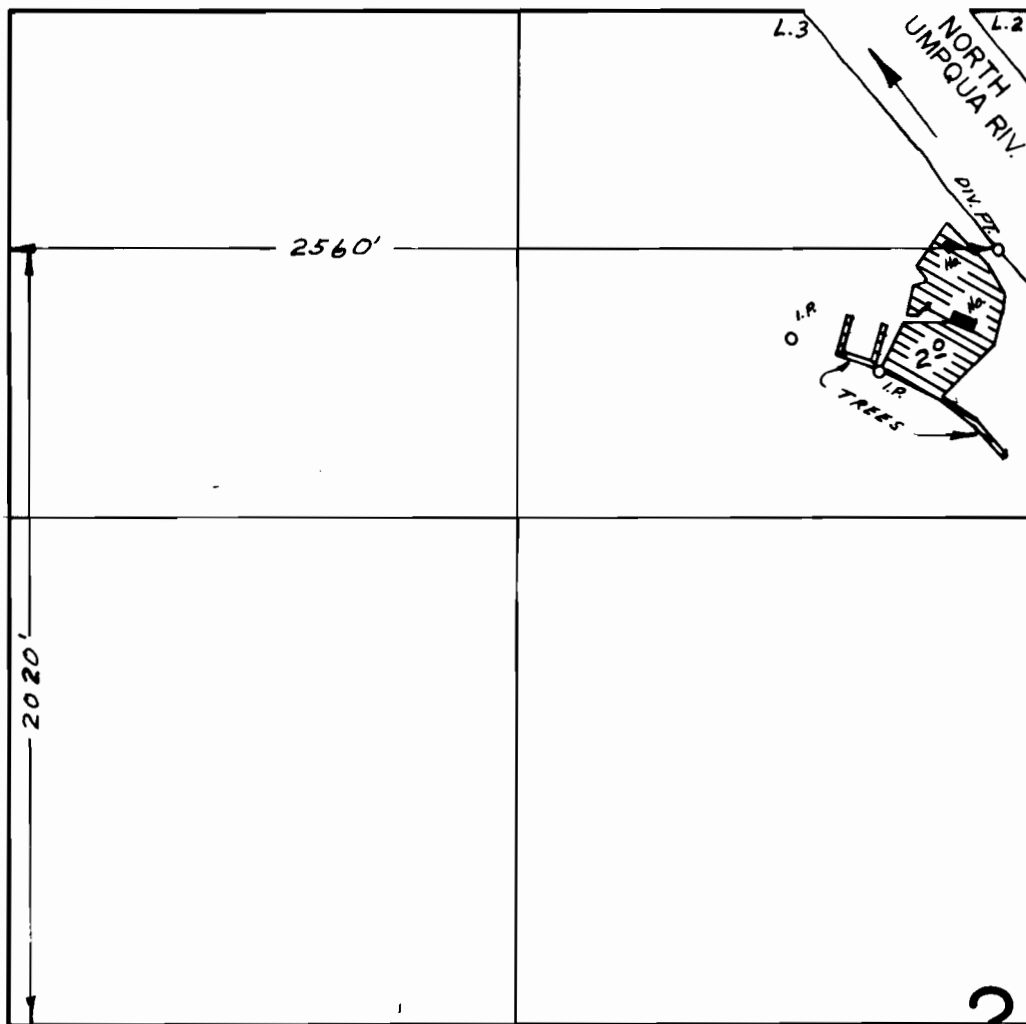

SCALE 1" = 500'

FINAL PROOF SURVEY UNDER

Application No. 53664... Permit No. 40126
IN NAME OF

ELI S. HALL

Surveyed SEP. 15. 1976, by L.H. NUNN