


T.22S.R.8 & 9W.W.M.

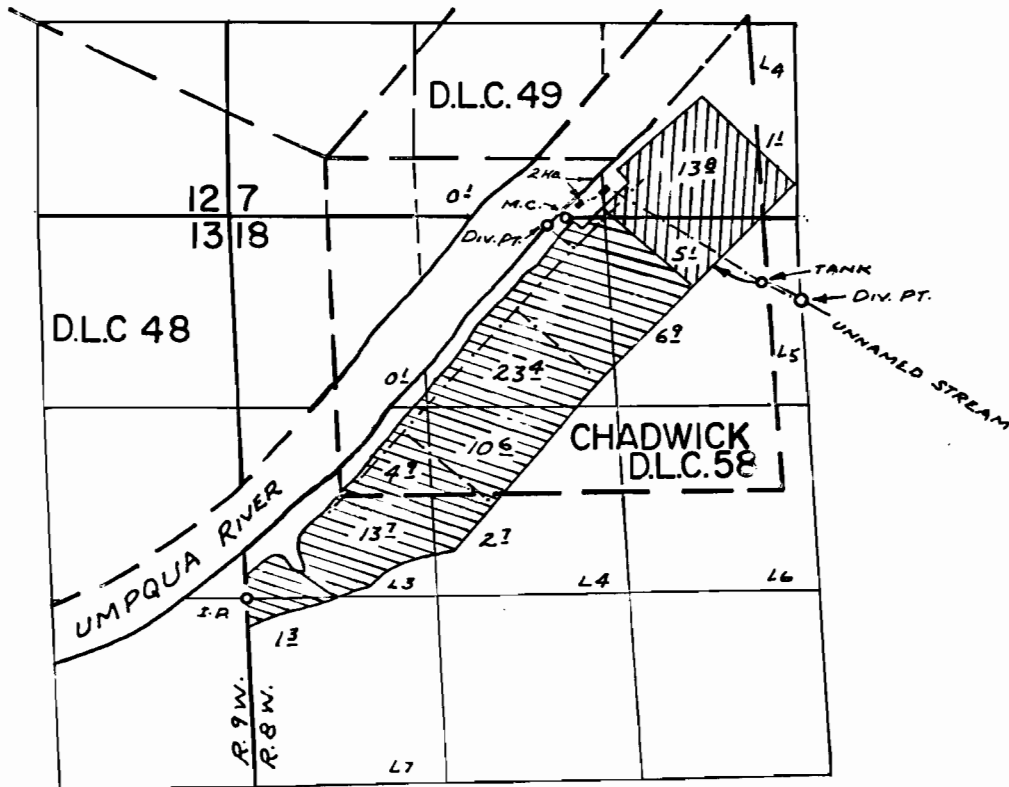

DIV. PTS. LOC: RIVER - 50'S. & 400'W ; UNN. STREAM - 580'S. & 1290'E. FROM N 1/2 COR. SEC. 18

FINAL PROOF SURVEY UNDER

Application No. 53738 Permit No. 40357
50550 38166
 IN NAME OF

FORREST SOLDMON

Surveyed MAY 11 1976., by R. MUGGEN