


T.39S., R.3W., W.M.

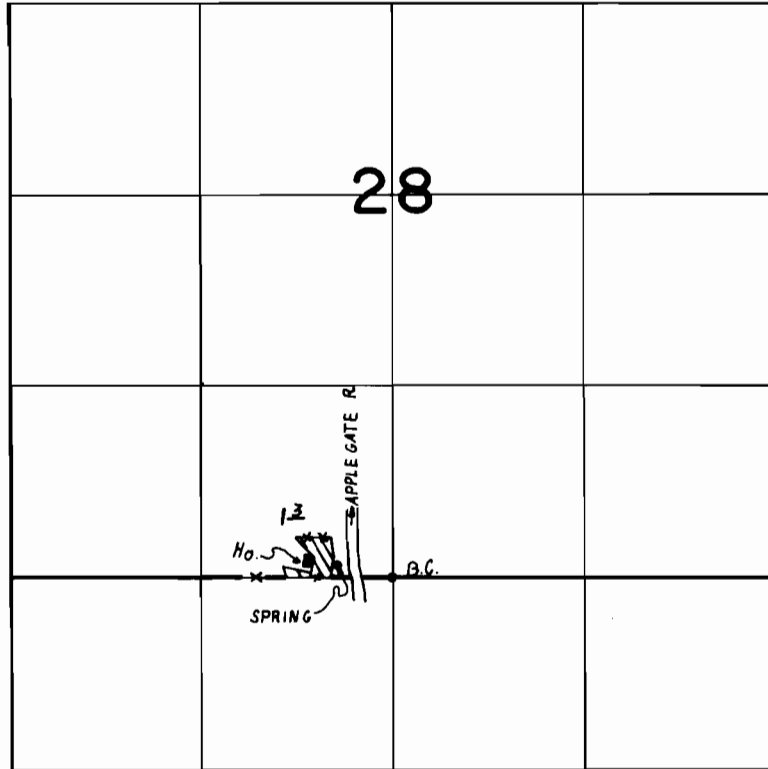

SPRING: 80' N & 370' W FROM THE S 1/4 COR. SEC. 28

**FINAL PROOF SURVEY**  
UNDER

Application No. 51676 Permit No. 38963  
IN NAME OF

FLOYD K. GRESS

Surveyed MAY 6, 1976, by C.R. KING