


T.36S. R.7 W. W.M.

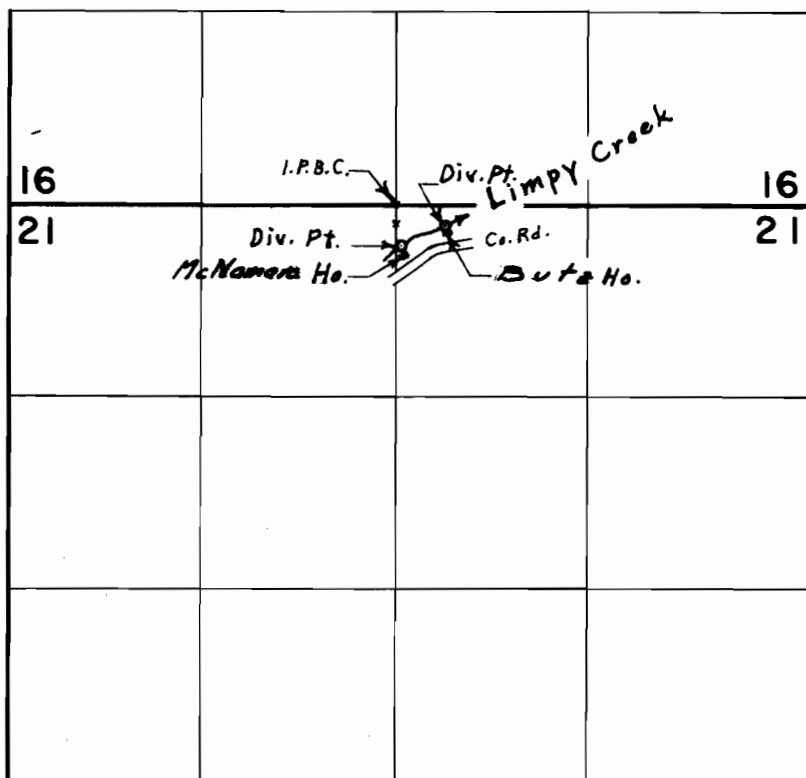

Div. Pts. located, 150' S. & 340' E., 270' S. & 30' E., both from N.  $\frac{1}{4}$  Corner Section 21

**FINAL PROOF SURVEY**  
UNDER

Application No. 4.8445. Permit No. 36363.

IN NAME OF

*Jerry A. & Frances M. Butz*  
*John & Cheryl S. McNamara*

Surveyed April 10, 1975, by L. E. Gauld.