


T.34 S. R.6 W. W.M.

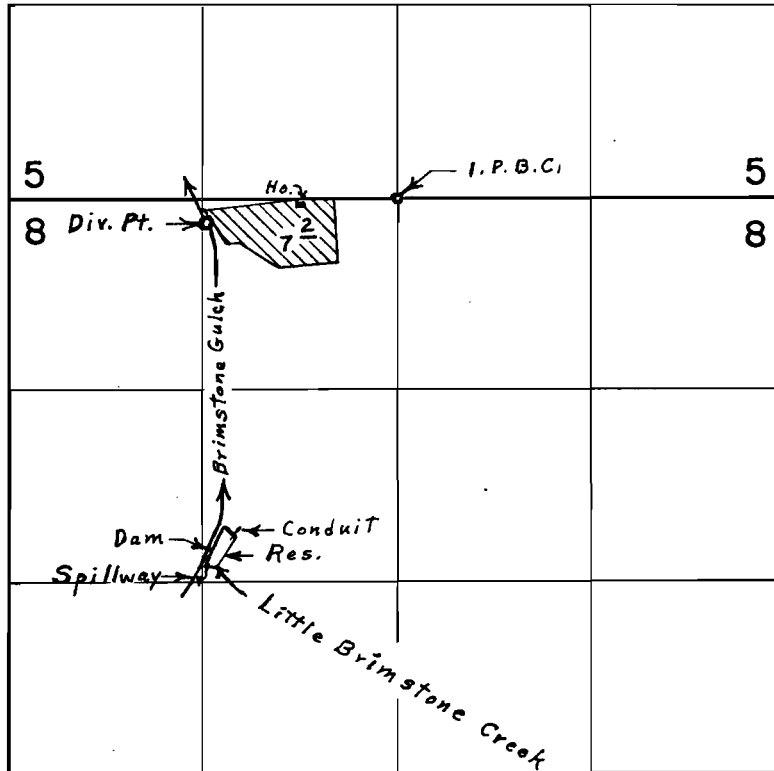

Div. Pts. located: Little Brimstone Creek, 2530'S. & 1230'W.;
 Brimstone Gulch Creek, 170'S. & 1300'W., both from N. $\frac{1}{4}$ Cor. Sec. 8

FINAL PROOF SURVEY UNDER

R-49010 R-5945
 R-46263 R-5504
 Application No. 46264. Permit No. 34563.
 IN NAME OF

CARL F. EHLIG

Surveyed April 5, 1975, by L. E. Gould.