
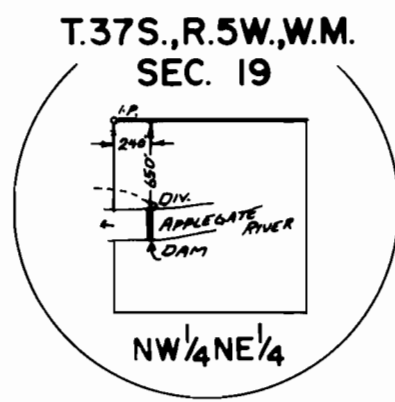


T.37S.,R.6W.,W.M.

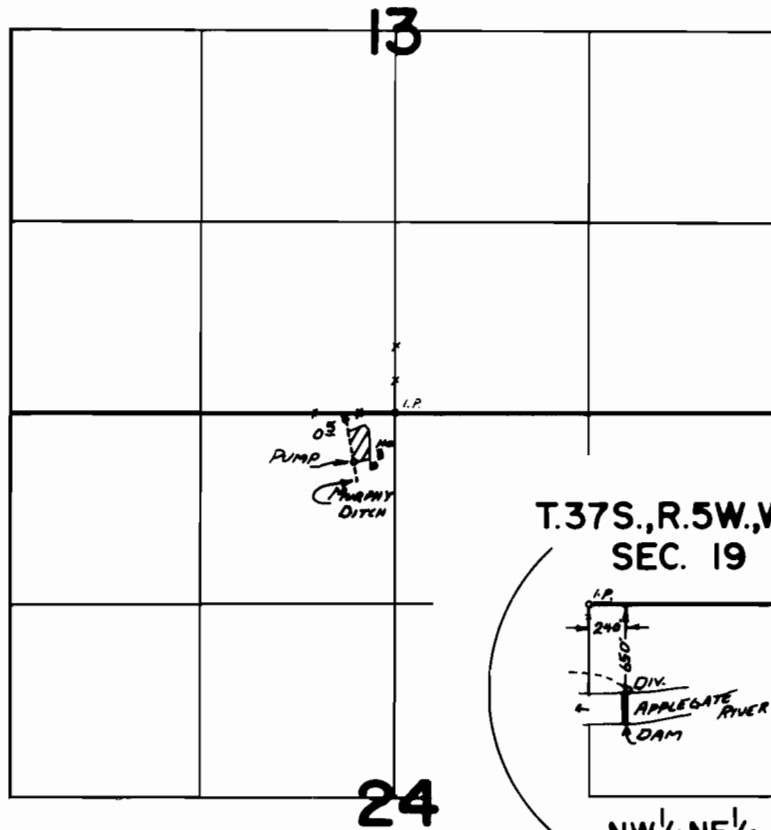

FINAL PROOF SURVEY
UNDER

Application No. 52121 Permit No. 39102
IN NAME OF

JOHN A. & BETTY E. EYERS

Surveyed MAY 1 1976, by L. TOLL